

WATER WELL RECORD Form WWC-5

Division of Water Resources App. No.

Well ID MW-4

Original Record Correction Change in Well Use

1 LOCATION OF WATER WELL: County: Ness	Fraction NW ¼ SE ¼ SW ¼ SW ¼	Section Number 31	Township Number T 18 S	Range Number R 21 <input type="checkbox"/> E <input checked="" type="checkbox"/> W
--	---------------------------------	----------------------	---------------------------	---

2 WELL OWNER: Last Name: First: Street or Rural Address where well is located (if unknown, distance and direction from nearest town or intersection): If at owner's address, check here: <input type="checkbox"/> Business: KDHE Address: 1000 SW Jackson St., Suite 410 Address: City: Topeka State: KS ZIP: 66612 214 North Main St.
--

3 LOCATE WELL WITH "X" IN SECTION BOX:

N

NW	NE
SW	SE

S

|-----1 mile-----|

4 DEPTH OF COMPLETED WELL: 42.5 ft.

Depth(s) Groundwater Encountered: 1) 25.05 ft.
 2) ft. 3) ft., or 4) Dry Well

WELL'S STATIC WATER LEVEL: ft.

below land surface, measured on (mo-day-yr).....
 above land surface, measured on (mo-day-yr).....

Pump test data: Well water was ft.
 after hours pumping gpm
 Well water was ft.
 after hours pumping gpm

Estimated Yield: gpm
 Bore Hole Diameter: 8.75 in. to 42.5 ft. and
 in. to ft.

5 Latitude: 38.444247 (decimal degrees)
Longitude: -99.691122 (decimal degrees)
Horizontal Datum: WGS 84 NAD 83 NAD 27
Source for Latitude/Longitude:
 GPS (unit make/model:)
 (WAAS enabled? Yes No)
 Land Survey Topographic Map
 Online Mapper:

6 Elevation: 2121.98 ft. Ground Level TOC
Source: Land Survey GPS Topographic Map
 Other

7 WELL WATER TO BE USED AS:

1. Domestic: <input type="checkbox"/> Household <input type="checkbox"/> Lawn & Garden <input type="checkbox"/> Livestock 2. <input type="checkbox"/> Irrigation 3. <input type="checkbox"/> Feedlot 4. <input type="checkbox"/> Industrial	5. <input type="checkbox"/> Public Water Supply: well ID 6. <input type="checkbox"/> Dewatering: how many wells? 7. <input type="checkbox"/> Aquifer Recharge: well ID 8. <input checked="" type="checkbox"/> Monitoring: well ID MW-4 9. Environmental Remediation: well ID <input type="checkbox"/> Air Sparge <input type="checkbox"/> Soil Vapor Extraction <input type="checkbox"/> Recovery <input type="checkbox"/> Injection	10. <input type="checkbox"/> Oil Field Water Supply: lease 11. Test Hole: well ID <input type="checkbox"/> Cased <input type="checkbox"/> Uncased <input type="checkbox"/> Geotechnical 12. Geothermal: how many bores? a) Closed Loop <input type="checkbox"/> Horizontal <input type="checkbox"/> Vertical b) Open Loop <input type="checkbox"/> Surface Discharge <input type="checkbox"/> Inj. of Water 13. <input type="checkbox"/> Other (specify):
---	--	---

Was a chemical/bacteriological sample submitted to KDHE? Yes No If yes, date sample was submitted:

Water well disinfected? Yes No

8 TYPE OF CASING USED: Steel PVC Other **CASING JOINTS:** Glued Clamped Welded Threaded

Casing diameter 2 in. to 42.5 ft., Diameter in. to ft., Diameter in. to ft.
 Casing height above land surface 36 in. Weight lbs./ft. Wall thickness or gauge No. sch 40

TYPE OF SCREEN OR PERFORATION MATERIAL:
 Steel Stainless Steel Fiberglass PVC Other (Specify)
 Brass Galvanized Steel Concrete tile None used (open hole)

SCREEN OR PERFORATION OPENINGS ARE:
 Continuous Slot Mill Slot Gauze Wrapped Torch Cut Drilled Holes Other (Specify)
 Louvered Shutter Key Punched Wire Wrapped Saw Cut None (Open Hole)

SCREEN-PERFORATED INTERVALS: From 32.5 ft. to 42.5 ft., From ft. to ft., From ft. to ft.
GRAVEL PACK INTERVALS: From 30.5 ft. to 42.5 ft., From ft. to ft., From ft. to ft.

9 GROUT MATERIAL: Neat cement Cement grout Bentonite Other

GROUT INTERVALS: From ft. to ft., From ft. to ft., From ft. to ft.


Nearest source of possible contamination:
 Septic Tank Lateral Lines Pit Privy Livestock Pens Insecticide Storage
 Sewer Lines Cess Pool Sewage Lagoon Fuel Storage Abandoned Water Well
 Watertight Sewer Lines Seepage Pit Feedyard Fertilizer Storage Oil Well/Gas Well
 Other (Specify)

Direction from well? Distance from well? ft.

10 FROM	TO	LITHOLOGIC LOG	FROM	TO	LITHO. LOG (cont.) or PLUGGING INTERVALS
0	5	Silt, brown, dry, stiff			
5	15	Silt, gray brown, dry, stiff			
15	24.8	Clay, brown, moist, plastic			
24.8	30	Sandy Clay, light brown, moist			
30	42.5	Sand, light brown, fine, wet			
Notes:					

11 CONTRACTOR'S OR LANDOWNER'S CERTIFICATION: This water well was constructed, reconstructed, or plugged under my jurisdiction and was completed on (mo-day-year) 1-22-2020 and this record is true to the best of my knowledge and belief. Kansas Water Well Contractor's License No. 604. This Water Well Record was completed on (mo-day-year) 2/24/20 under the business name of Environmental Priority Service, Inc. Signature *P. H. H. H.*

Draft

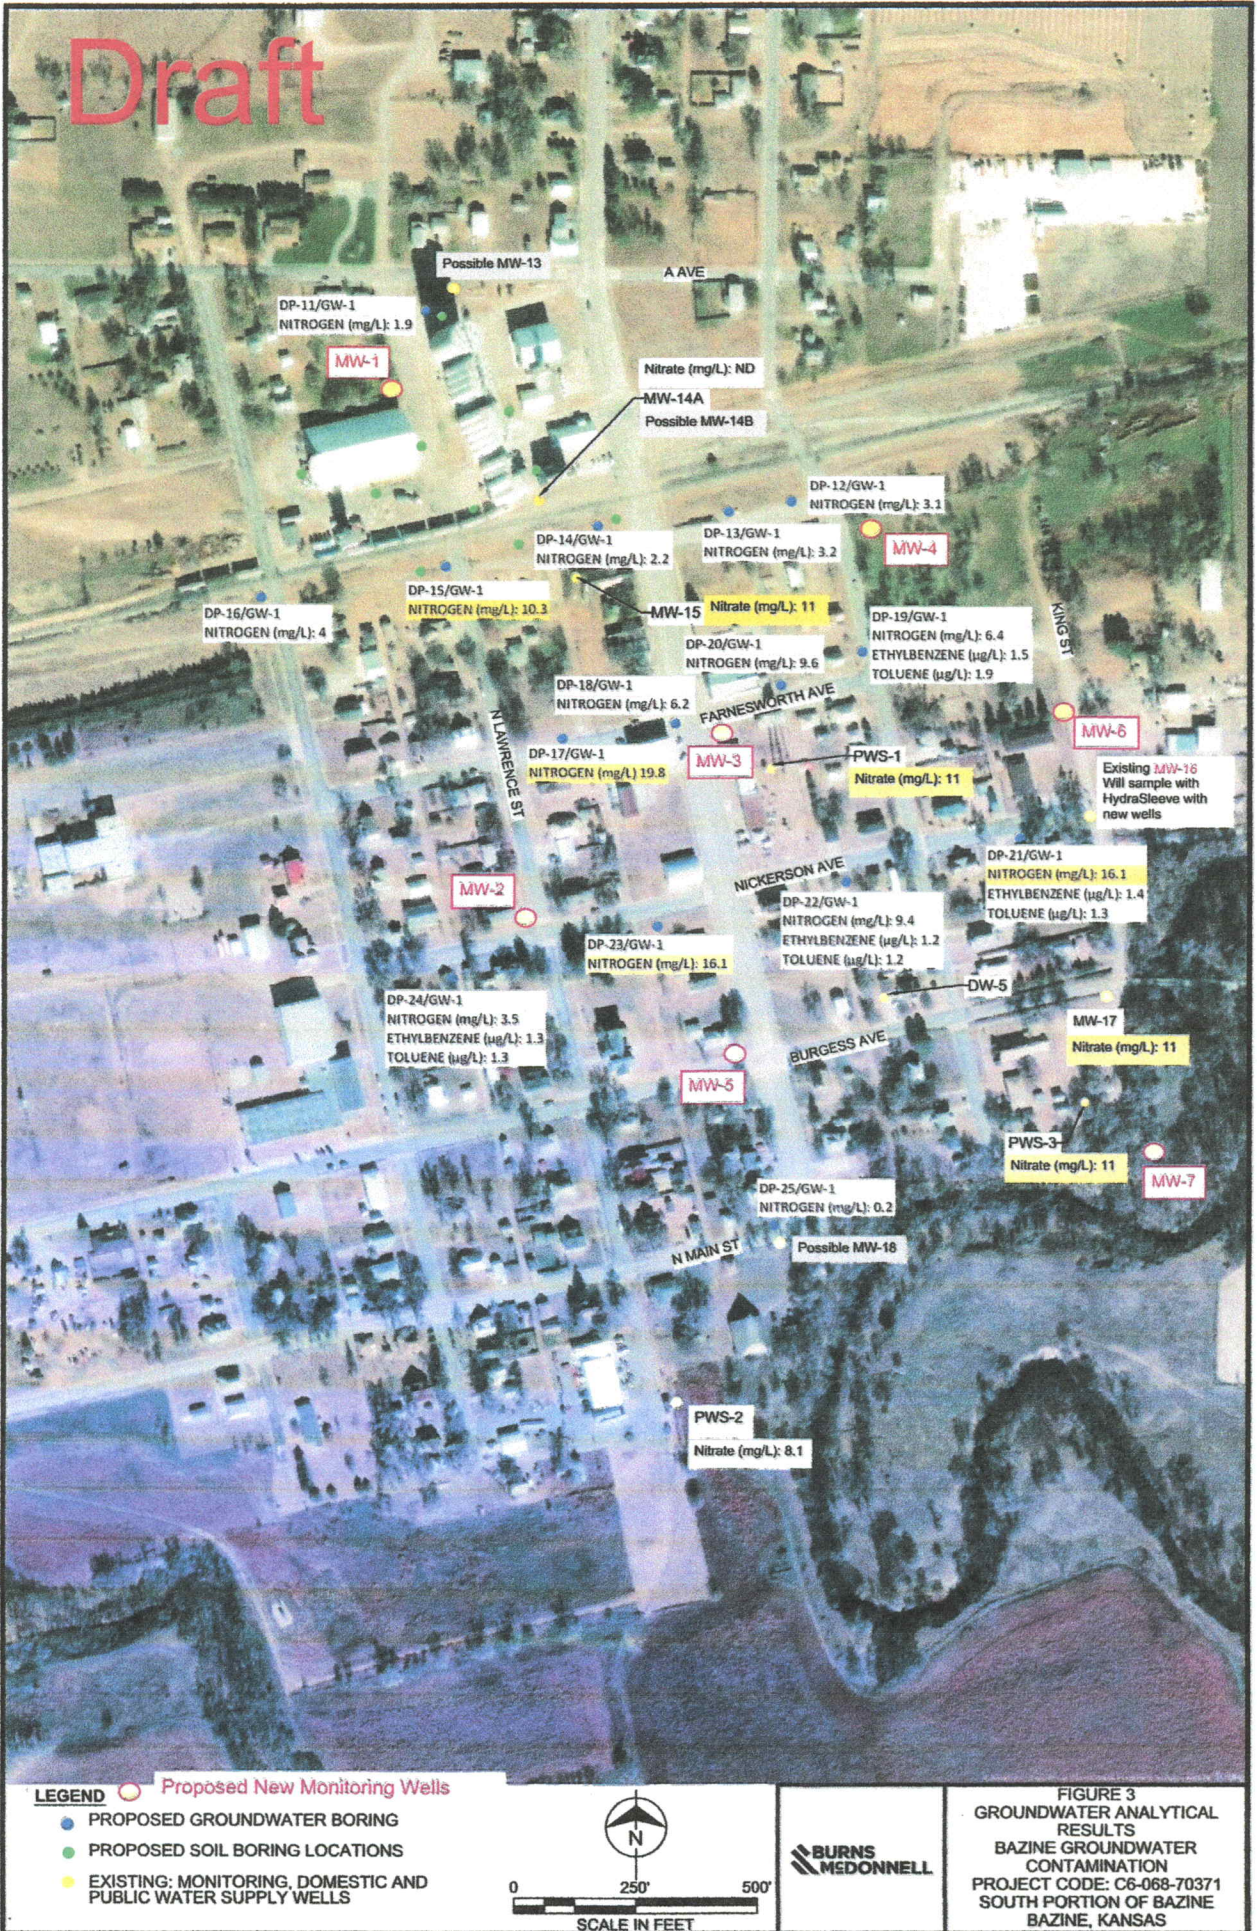

COPYRIGHT © 2019 BURNS & MCDONNELL ENGINEERING COMPANY, INC.

Z:\Clients\EN\KADHE\115232_Bazine\GW\Design\CADD\DWG\115232_Bazine\FG2 - Locations.dwg 1/16/2019 TMO\JLLS