


1 LOCATION OF WATER WELL: County: NESS Fraction: SW 1/4 NE 1/4 NE 1/4 Section Number: 18 Township Number: T 18 S Range Number: R 91 EW

Distance and direction from nearest town or city street address of well if located within city?
3 MI NORTH + 1/2 MI EAST OF BAZINE, KS.

2 WATER WELL OWNER: LAVERNE BOTH
 RR#, St. Address, Box #: 1500 EAST BLENDOKS
 City, State, ZIP Code: GLENDALE, CALIFORNIA 91206
 Board of Agriculture, Division of Water Resources
 Application Number:

3 LOCATE WELL'S LOCATION WITH AN "X" IN SECTION BOX: 4 DEPTH OF COMPLETED WELL: 8 ft. ELEVATION:

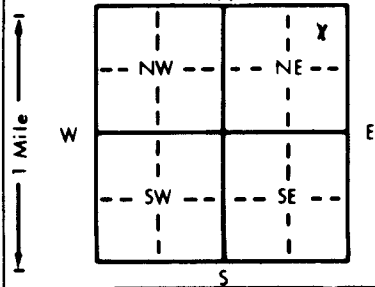

Depth(s) Groundwater Encountered: 1 ft. 2. ft. 3. ft.
 WELL'S STATIC WATER LEVEL: 5 ft. below land surface measured on mo/day/yr
 Pump test data: Well water was _____ ft. after _____ hours pumping _____ gpm
 Est. Yield _____ gpm: Well water was _____ ft. after _____ hours pumping _____ gpm
 Bore Hole Diameter _____ in. to _____ ft., and _____ in. to _____ ft.
 WELL WATER TO BE USED AS:
 5 Public water supply 8 Air conditioning 11 Injection well
 1 Domestic 3 Feedlot 6 Oil field water supply 9 Dewatering 12 Other (Specify below)
 2 Irrigation 4 Industrial 7 Lawn and garden only 10 Monitoring well
 Was a chemical/bacteriological sample submitted to Department? Yes No _____; If yes, mo/day/yr sample was submitted
 Water Well Disinfected? Yes No

5 TYPE OF BLANK CASING USED:
 1 Steel 3 RMP (SR) 5 Wrought iron 8 Concrete tile CASING JOINTS: Glued _____ Clamped _____
 2 PVC 4 ABS 6 Asbestos-Cement 9 Other (specify below) Welded _____
 7 Fiberglass NONE Threaded _____
 Blank casing diameter 4.0 in. to _____ ft., Dia _____ in. to _____ ft., Dia _____ in. to _____ ft.
 Casing height above land surface 30 in., weight _____ lbs./ft. Wall thickness or gauge No. _____

TYPE OF SCREEN OR PERFORATION MATERIAL:
 1 Steel 3 Stainless steel 5 Fiberglass 8 RMP (SR) 10 Asbestos-cement 11 Other (specify) NA
 2 Brass 4 Galvanized steel 6 Concrete tile 9 ABS 12 None used (open hole)

SCREEN OR PERFORATION OPENINGS ARE:
 1 Continuous slot 3 Mill slot 5 Gauzed wrapped 8 Saw cut 11 None (open hole)
 2 Louvered shutter 4 Key punched 6 Wire wrapped 9 Drilled holes
 7 Torch cut 10 Other (specify) NA

SCREEN-PERFORATED INTERVALS: From NA ft. to NA ft., From _____ ft. to _____ ft.
 GRAVEL PACK INTERVALS: From _____ ft. to _____ ft., From _____ ft. to _____ ft.

6 GROUT MATERIAL: 1 Neat cement 2 Cement grout 3 Bentonite 4 Other _____
 Grout Intervals: From 5 ft. to 4.5 ft., From _____ ft. to _____ ft., From _____ ft. to _____ ft.

What is the nearest source of possible contamination:
 1 Septic tank 4 Lateral lines 7 Pit privy 10 Livestock pens 14 Abandoned water well
 2 Sewer lines 5 Cess pool 8 Sewage lagoon 11 Fuel storage 15 Oil well/Gas well
 3 Watertight sewer lines 6 Seepage pit 9 Feedyard 12 Fertilizer storage 16 Other (specify below)
 13 Insecticide storage NONE

Direction from well? _____ How many feet? _____

FROM	TO	LITHOLOGIC LOG	FROM	TO	PLUGGING INTERVALS
					<u>HARD DUG WELL</u>
			<u>0</u>	<u>8 ft</u>	<u>Took Rock + DIRT out</u>
			<u>8 ft</u>	<u>5 ft</u>	<u>DISINFECTED</u>
			<u>5 ft</u>	<u>4 ft</u>	<u>WASHED SAND</u>
			<u>4 ft</u>	<u>4 ft</u>	<u>BENTONITE</u>
				<u>0</u>	<u>NEW CLAY + DIRT</u>

7 CONTRACTOR'S OR LANDOWNER'S CERTIFICATION: This water well was (1) constructed, (2) reconstructed, or (3) plugged under my jurisdiction and was completed on (mo/day/year) 8-12-94 and this record is true to the best of my knowledge and belief. Kansas Water Well Contractor's License No. 423 This Water Well Record was completed on (mo/day/yr) 9-6-94 under the business name of CLINE DRILLING CO. by (signature) Jack N. Cline

OFFICE USE ONLY
T
R
EW
SEC.