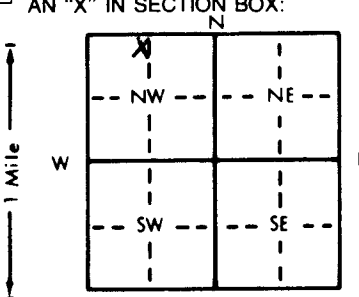


1 LOCATION OF WATER WELL: Fraction NE 1/4 NW 1/4 NW 1/4 Section Number 18 Township Number T 18 S Range Number R 22 EW
 County: NESS

Distance and direction from nearest town or city street address of well if located within city?
6 MI WEST OF BAZINIE + 3 MI NORTH

2 WATER WELL OWNER: VERNON SCHWARTZ
 RR#, St. Address, Box # : #1 Board of Agriculture, Division of Water Resources
 City, State, ZIP Code : BROWNELL, KS 67521 Application Number:

3 LOCATE WELL'S LOCATION WITH AN "X" IN SECTION BOX:

 4 DEPTH OF COMPLETED WELL: 22 ft. ELEVATION:




FROM	TO	LITHOLOGIC LOG	FROM	TO	PLUGGING INTERVALS
		<u>PLUGGED HAND DRILL WELL</u>	<u>20'</u>	<u>28'</u>	<u>SAND - CLAY</u>
			<u>5'</u>	<u>20'</u>	<u>CLAY</u>
			<u>5'</u>	<u>5'</u>	<u>BENTONITE</u>
			<u>0'</u>	<u>5'</u>	<u>DIRT</u>

7 CONTRACTOR'S OR LANDOWNER'S CERTIFICATION: This water well was (1) constructed, (2) reconstructed, or (3) plugged under my jurisdiction and was completed on (mo/day/year) 8-3-93 and this record is true to the best of my knowledge and belief. Kansas Water Well Contractor's License No. 41317 This Water Well Record was completed on (mo/day/yr) 8-17-93 under the business name of CLINE DRILLING CO. by (signature) Jack D. Cline

INSTRUCTIONS: Use typewriter or ball point pen. PLEASE PRESS FIRMLY and PRINT clearly. Please fill in blanks, underline or circle the correct answers. Send top three copies to Kansas Department of Health and Environment, Bureau of Water, Topeka, Kansas 66620-0001. Telephone: 913-296-5545. Send one to WATER WELL OWNER and retain one for your records.

OFFICE USE ONLY
T
R
EW
SEC
1/4
1/4
1/4