USE TYPEWRITER OR BALL POINT PEN-PRESS FIRMLY, PRINT CLEARLY.

WATER WELL RECORD
KSA 82a-1201-1215

Kansas Department of Health and Environment-Division of Environment
(Water well Contractors)
Topeka, Kansas 66620

| 1. Location of well: | County | Fraction | Section number | Township number | Range number |
|---|---|---|---|---|---|
| | Ness | NW 1/4 NW 1/4 NW 1/4 | 36 | T 18 S | R 22 E/W |

2. Distance and direction from nearest town or city: 1/2 m E of Bazine → 36 BBB is West of Bazine
Street address of well location if in city:

3. Owner of well: Paul Foos
R.R. or street:
City, state, zip code: Bazine, Ks.

4. Locate with "X" in section below:

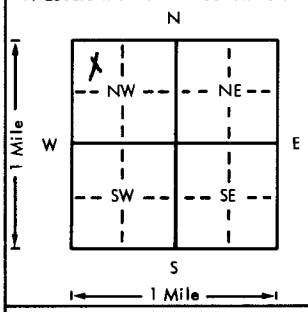


Sketch map: location?

6. Bore hole dia. 29 in. Completion date 6-9-75
Well depth 59 ft.

7. __ Coble tool ✓ Rotary __ Driven __ Dug
__ Hollow rod __ Jetted __ Bored __ Reverse rotary

8. Use: __ Domestic __ Public supply __ Industry
✓ Irrigation __ Air conditioning __ Stock
__ Lawn __ Oil field water __ Other

9. Casing: Material Steel Height: (Above) or ~~below~~
Threaded ___ Welded ✓ Surface 18 in.
RMP ___ PVC ___ Weight ___ lbs./ft.
Dia 16 in. to 59 ft. depth Wall Thickness: inches or
Dia. ___ in. to ___ ft. depth gage No. ___

| 5. Type and color of material | From | To |
|---|---|---|
| Top Soil | 0 | 2 |
| Dk. Brown Clay | 2 | 15 |
| Lt. Brown Clay | 15 | 31 |
| Sand & Gravel loose clean | 31 | 35 |
| Fine Sand & Gravel Some Clay | 35 | 45 |
| Gray Clay | 45 | 50 |
| Sand & Gravel loose Coarse little Clay | 50 | 59 |
| Yellow Brown Lt. Gray Clay | 59 | 60 |
| Shale | 60 | |
| DR 59' 7hm | | |

(Use a second sheet if needed)

10. Screen: Manufacturer's name Devers
Type steel Dia. 16
Slot/gauze 3/16 Length 10
Set between 49 ft. and 59 ft.
___ ft. and ___ ft.
Gravel pack? ✓ Size range of material 1/2 3/4 3/8

11. Static water level: mo./day/yr.
___ ft. below land surface Date ___

12. Pumping level below land surfaces:
___ ft. after ___ hrs. pumping NA g.p.m.
___ ft. after ___ hrs. pumping ___ g.p.m.
Estimated maximum yield ___ g.p.m.

13. Water sample submitted: mo./day/yr.
✓ Yes ___ No Date 5-20-75

14. Well head completion:
___ Pitless adapter ___ Inches above grade

15. Well grouted? ✓
With: ✓ Neat cement ___ Bentonite ___ Concrete
Depth: From 0 ft. to 10 ft.

16. Nearest source of possible contamination:
ft. 1/4 Direction N Type Corral
Well disinfected upon completion? ___ Yes ___ No

17. Pump: ___ Not installed
Manufacturer's name Reimaster
Model number SR6M1EM HP 3 Volts 230
Length of drop pipe 50 ft. capacity ___ g.p.m.
Type:
✓ Submersible ___ Turbine
___ Jet ___ Reciprocating
___ Centrifugal ___ Other

18. Elevation:
Topography:
___ Hill
___ Slope
✓ Upland
___ Valley

19. Remarks:

20. Water well contractor's certification:
This well was drilled under my jurisdiction and this report is true to the best of my knowledge and belief.
Rosencrantz-Bemis 134
Business name License No.
Address Great Bend, Ks.
Signed Freda Dodson Date 9/30/76
Authorized representative

T 18 S R 22 E/W Sec 36 1/4 NW 1/4 1/4

Forward the white, blue and pink copies to the Department of Health and Environment

Form WWC-5

MI-1023