


1 LOCATION OF WATER WELL: County: Ness Fraction NE 1/4 SW 1/4 SE 1/4 Section Number 30 Township Number T 18 S Range Number R 23 EW

Distance and direction from nearest town or city street address of well if located within city? 202 S. Pennsylvania - Ness City, Kansas

2 WATER WELL OWNER: Ness City Auto Supply, Inc. RR#, St. Address, Box #: 202 S. Pennsylvania Board of Agriculture, Division of Water Resources City, State, ZIP Code: Ness City, Kansas 67560 Application Number:

3 LOCATE WELL'S LOCATION WITH AN "X" IN SECTION BOX:

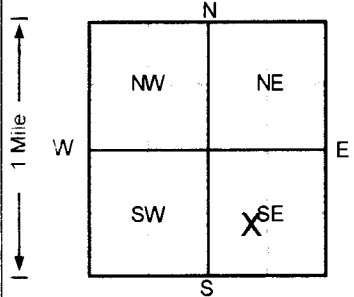

4 DEPTH OF COMPLETED WELL: 29 ft. ELEVATION: 2248.81. Depth(s) Groundwater Encountered: 1. 25 ft. 2. ft. 3. ft. WELL'S STATIC WATER LEVEL: 24.55 ft. below land surface measured on mo/day/yr 1/22/97. Pump test data: Well water was NA ft. after hours pumping gpm. Est. Yield NA gpm: Well water was ft. after hours pumping gpm. Bore Hole Diameter: 8 in. to 29 ft. and in. to ft. WELL WATER TO BE USED AS: 5 Public water supply 8 Air conditioning 11 Injection well 1 Domestic 3 Feedlot 6 Oil field water supply 9 Dewatering 12 Other (Specify below) 2 Irrigation 4 Industrial 7 Lawn and garden only 10 Monitoring well. Was a chemical/bacteriological sample submitted to Department? Yes No; If yes, mo/day/yr sample was submitted. Water Well Disinfected? Yes No

5 TYPE OF BLANK CASING USED: 1 Steel 2 PVC 3 RMP (SR) 4 ABS 5 Wrought iron 6 Asbestos-Cement 7 Fiberglass 8 Concrete tile 9 Other (specify below) CASING JOINTS: Glued Clamped Welded Threaded. Blank casing diameter: 2 in. to 19 ft. Dia in. to ft. Dia in. to ft. Casing height above land surface: -4.56 in., weight lbs./ft. Wall thickness or gauge No. Sch. 40

TYPE OF SCREEN OR PERFORATION MATERIAL: 1 Steel 2 Brass 3 Stainless steel 4 Galvanized steel 5 Fiberglass 6 Concrete tile 7 PVC 8 RMP (SR) 9 ABS 10 Asbestos-cement 11 Other (specify) 12 None used (open hole)

SCREEN OR PERFORATION OPENINGS ARE: 1 Continuous slot 2 Louvered shutter 3 Mill slot 4 Key punched 5 Gauzed wrapped 6 Wire wrapped 7 Torch cut 8 Saw cut 9 Drilled holes 10 Other (specify) 11 None (open hole)

SCREEN-PERFORATED INTERVALS: From 19 ft. to 29 ft. GRAVEL PACK INTERVALS: From 16 ft. to 29 ft.

6 GROUT MATERIAL: 1 Neat cement 2 Cement grout 3 Bentonite 4 Other. Grout Intervals: From 0 ft. to 14 ft. From 14 ft. to 16 ft. What is the nearest source of possible contamination: 1 Septic tank 2 Sewer lines 3 Watertight sewer lines 4 Lateral lines 5 Cess pool 6 Seepage pit 7 Pit privy 8 Sewage lagoon 9 Feedyard 10 Livestock pens 11 Fuel storage 12 Fertilizer storage 13 Insecticide storage 14 Abandoned water well 15 Oil well/Gas well 16 Other (specify below) UST Basin. Direction from well? NE How many feet? 260

Table with columns: FROM, TO, LITHOLOGIC LOG, FROM, TO, PLUGGING INTERVALS. Rows: 0-1 Topsoil, 1-10 Clay, Dark Gray to Black, 10-23 Silt, Light Brown, 23-28 Sand, Light Brown, 28-29 Shale, Dark Gray.

7 CONTRACTOR'S OR LANDOWNER'S CERTIFICATION: This water well was (1) constructed, (2) reconstructed, or (3) plugged under my jurisdiction and was completed on (mo/day/year) 1/22/97 and this record is true to the best of my knowledge and belief. Kansas Water Well Contractor's License No. 527. This Water Well Record was completed on (mo/day/yr) 2/21/97 under the business name of GeoCore Services, Inc. by (signature) Dale Robb