


241150 MW-40

1 LOCATION OF WATER WELL: County: <u>Ness</u>	Fraction: <u>NE 1/4 SW 1/4 NE 1/4</u>	Section Number: <u>31</u>	Township Number: <u>T 18 S</u>	Range Number: <u>R 23 EW</u>
--	---------------------------------------	---------------------------	--------------------------------	------------------------------

Distance and direction from nearest town or city street address of well if located within city?
140' E of Cherry St. and Kansar Ave. - Ness City, KS

2 WATER WELL OWNER: City of Ness City
 RR#, St. Address, Box #: Ness City, KS 67560
 City, State, ZIP Code: Ness City, KS 67560
 Board of Agriculture, Division of Water Resources
 Application Number: _____

3 LOCATE WELL'S LOCATION WITH AN "X" IN SECTION BOX:

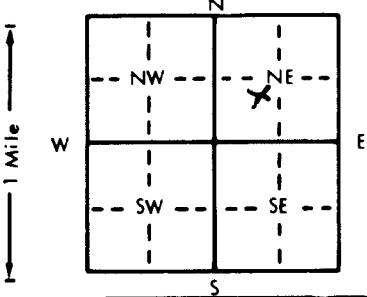

4 DEPTH OF COMPLETED WELL: 50' ft. ELEVATION: 2248.96
 Depth(s) Groundwater Encountered 1. 43' ft. 2. _____ ft. 3. _____ ft.
 WELL'S STATIC WATER LEVEL 40.43 ft. below land surface measured on mo/day/yr 4/8/97
 Pump test data: Well water was _____ ft. after _____ hours pumping _____ gpm
 Est. Yield _____ gpm Well water was _____ ft. after _____ hours pumping _____ gpm
 Bore Hole Diameter 6.5 in. to 50' ft. and _____ in. to _____ ft.
 WELL WATER TO BE USED AS:
 5 Public water supply 8 Air conditioning 11 Injection well
 1 Domestic 3 Feedlot 6 Oil field water supply 9 Dewatering 12 Other (Specify below)
 2 Irrigation 4 Industrial 7 Lawn and garden only 10 Monitoring well MW-40
 Was a chemical/bacteriological sample submitted to Department? Yes _____ No X; If yes, mo/day/yr sample was submitted _____
 Water Well Disinfected? Yes _____ No X

5 TYPE OF BLANK CASING USED:
 1 Steel 3 RMP (SR) 5 Wrought iron 8 Concrete tile CASING JOINTS: Glued _____ Clamped _____
 2 PVC 4 ABS 6 Asbestos-Cement 9 Other (specify below) Welded _____
 7 Fiberglass Threaded X
 Blank casing diameter 2" in. to 40 ft., Dia _____ in. to _____ ft., Dia _____ in. to _____ ft.
 Casing height above land surface Flush in., weight _____ lbs./ft. Wall thickness or gauge No. Sch 40
 TYPE OF SCREEN OR PERFORATION MATERIAL:
 1 Steel 3 Stainless steel 5 Fiberglass 8 RMP (SR) 11 Other (specify) _____
 2 Brass 4 Galvanized steel 6 Concrete tile 9 ABS 12 None used (open hole)
 SCREEN OR PERFORATION OPENINGS ARE:
 1 Continuous slot 3 Mill slot 5 Gauzed wrapped 8 Saw cut 11 None (open hole)
 2 Louvered shutter 4 Key punched 6 Wire wrapped 9 Drilled holes
 7 Torch cut 10 Other (specify) _____
 SCREEN-PERFORATED INTERVALS: From 40 ft. to 50 ft., From _____ ft. to _____ ft.
 From _____ ft. to _____ ft., From _____ ft. to _____ ft.
 GRAVEL PACK INTERVALS: From 38 ft. to 50 ft., From _____ ft. to _____ ft.
 From _____ ft. to _____ ft., From _____ ft. to _____ ft.

6 GROUT MATERIAL: 1 Neat cement 2 Cement grout 3 Bentonite 4 Other _____
 Grout Intervals: From 1 ft. to 38 ft., From _____ ft. to _____ ft., From _____ ft. to _____ ft.
 What is the nearest source of possible contamination:
 1 Septic tank 4 Lateral lines 7 Pit privy 10 Livestock pens 14 Abandoned water well
 2 Sewer lines 5 Cess pool 8 Sewage lagoon 11 Fuel storage (Farmer) 15 Oil well/Gas well
 3 Watertight sewer lines 6 Seepage pit 9 Feedyard 12 Fertilizer storage 16 Other (specify below)
 13 Insecticide storage
 Direction from well? N How many feet? 900'

FROM	TO	LITHOLOGIC LOG	FROM	TO	PLUGGING INTERVALS
0	43'	Silty Clay, brun, lt. brown			
43	49	Sand, lt. brown			
49	50'	Shale, dk gray			

7 CONTRACTOR'S OR LANDOWNER'S CERTIFICATION: This water well was (1) constructed, (2) reconstructed, or (3) plugged under my jurisdiction and was completed on (mo/day/year) 4/8/97 and this record is true to the best of my knowledge and belief. Kansas Water Well Contractor's License No. 531 This Water Well Record was completed on (mo/day/yr) 4/8/97 under the business name of BSI by (signature) [Signature]