


1 LOCATION OF WATER WELL: Fraction NW 1/4 SW 1/4 SE 1/4 Section Number 30 Township Number T 18 S Range Number R 23 EW
 County: Ness

Distance and direction from nearest town or city street address of well if located within city?
302 West Sycamore, Ness City, Ks.

2 WATER WELL OWNER: Harold Gabel
 RR#, St. Address, Box # : 301 W. Sycamore Board of Agriculture, Division of Water Resources
 City, State, ZIP Code : Ness City, KS. 67501 Application Number:

3 LOCATE WELL'S LOCATION WITH AN "X" IN SECTION BOX:

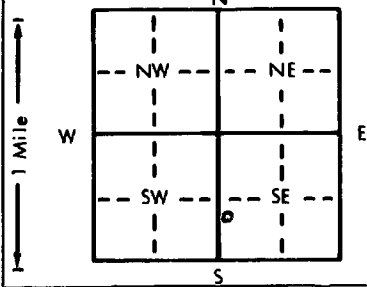

4 DEPTH OF COMPLETED WELL: 40' ft. ELEVATION:
 Depth(s) Groundwater Encountered 1.35' ft. 2. ft. 3. ft.
 WELL'S STATIC WATER LEVEL 34.11 ft. below land surface measured on mo/day/yr 8-12-98
 Pump test data: Well water was ft. after hours pumping gpm
 Est. Yield gpm; Well water was ft. after hours pumping gpm
 Bore Hole Diameter: 8 1/2" in. to 40' ft., and in. to ft.
 WELL WATER TO BE USED AS: 5 Public water supply 8 Air conditioning 11 Injection well
 1 Domestic 3 Feedlot 6 Oil field water supply 9 Dewatering 12 Other (Specify below)
 2 Irrigation 4 Industrial 7 Lawn and garden only 10 Monitoring well
 Was a chemical/bacteriological sample submitted to Department? Yes.....No X.....; If yes, mo/day/yr sample was submitted
 Water Well Disinfected? Yes No

5 TYPE OF BLANK CASING USED: 5 Wrought iron 8 Concrete tile CASING JOINTS: Glued Clamped
 1 Steel 3 RMP (SR) 6 Asbestos-Cement 9 Other (specify below) Welded
2 PVC 4 ABS 7 Fiberglass Threaded... X

Blank casing diameter 2.375 in. to 25' ft., Dia in. to ft., Dia in. to SDR 13 ft.
 Casing height above land surface Flush Mt. in., weight lbs./ft. Wall thickness or gauge No. SC3 40

TYPE OF SCREEN OR PERFORATION MATERIAL: 7 PVC 10 Asbestos-cement
 1 Steel 3 Stainless steel 5 Fiberglass 8 RMP (SR) 11 Other (specify)
 2 Brass 4 Galvanized steel 6 Concrete tile 9 ABS 12 None used (open hole)

SCREEN OR PERFORATION OPENINGS ARE: 5 Gauzed wrapped 8 Saw cut 11 None (open hole)
 1 Continuous slot 3 Mill slot 6 Wire wrapped 9 Drilled holes
 2 Louvered shutter 4 Key punched 7 Torch cut 10 Other (specify)

SCREEN-PERFORATED INTERVALS: From 40' ft. to 25' ft., From ft. to ft.
 From ft. to ft., From ft. to ft.
 GRAVEL PACK INTERVALS: From 40' ft. to 23' ft., From ft. to ft.
 From ft. to ft., From ft. to ft.

6 GROUT MATERIAL: 1 Neat cement 2 Cement grout 3 Bentonite 4 Other
 Grout intervals: From 23' ft. to 4' ft., From 4' ft. to 0' ft., From ft. to ft.

What is the nearest source of possible contamination: 10 Livestock pens 14 Abandoned water well
 1 Septic tank 4 Lateral lines 7 Pit privy 11 Fuel storage 15 Oil well/Gas well
 2 Sewer lines 5 Cess pool 8 Sewage lagoon 12 Fertilizer storage 16 Other (specify below)
 3 Watertight sewer lines 6 Seepage pit 9 Feedyard 13 Insecticide storage
 Direction from well? South How many feet? 750'

FROM	TO	LITHOLOGIC LOG	FROM	TO	PLUGGING INTERVALS
0	5	Grass, Dirt, - Fill to 5'			
5	15	Silty clay, Brn, non plastic, no odor			
15	21	Clay, Brn, Hard, Fissile			
21	23	Silt, Brn, soft, Dry, Friable			
23	25	Sand, Dry, coarse sorted sm-lc grained, no odor			
25	30	Silt, Brn, Dry-moist @30' oxide streaked, Caliche			
30	35	SAND, sm-lc grained, moist			F1 mt OK'd by Don Taylor
35	40	Silt, grading to silty clay @ 38-39' Soft, wet, oxides			

7 CONTRACTOR'S OR LANDOWNER'S CERTIFICATION: This water well was (1) constructed, (2) reconstructed, or (3) plugged under my jurisdiction and was completed on (mo/day/year) 8-12-98 and this record is true to the best of my knowledge and belief. Kansas Water Well Contractor's License No. 539 This Water Well Record was completed on (mo/day/yr) 10-8-98 under the business name of JB Environmental Drilling by (signature) James Buber

OFFICE USE ONLY
T
R
EW
SEC.
1/4
1/4
1/4