


1] LOCATION OF WATER WELL: County: Ness Fraction: NW 1/4 SW 1/4 SW 1/4 Section Number: 30 Township Number: T 18 S Range Number: R 23 EW

Distance and direction from nearest town or city street address of well if located within city?

2] WATER WELL OWNER: Westside Serv. 918 W. Sycamore St. Ness City, KS 67560 Board of Agriculture, Division of Water Resources Application Number: A52

3] LOCATE WELL'S LOCATION WITH AN "X" IN SECTION BOX:

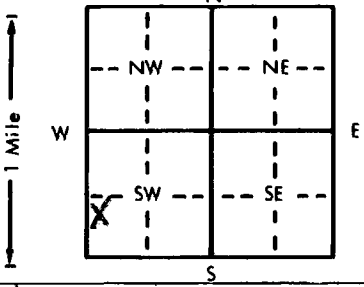

4] DEPTH OF COMPLETED WELL: 39.5 ft. ELEVATION: \_\_\_\_\_

Depth(s) Groundwater Encountered 1. \_\_\_\_\_ ft. 2. \_\_\_\_\_ ft. 3. \_\_\_\_\_ ft.

WELL'S STATIC WATER LEVEL: 32.8 ft. below land surface measured on mo/day/yr

Pump test data: Well water was \_\_\_\_\_ ft. after \_\_\_\_\_ hours pumping \_\_\_\_\_ gpm

Est. Yield \_\_\_\_\_ gpm: Well water was \_\_\_\_\_ ft. after \_\_\_\_\_ hours pumping \_\_\_\_\_ gpm

Bore Hole Diameter: 8 in. to 39.5 ft., and \_\_\_\_\_ in. to \_\_\_\_\_ ft.

WELL WATER TO BE USED AS:

5 Public water supply	8 Air conditioning	11 Injection well
1 Domestic	3 Feedlot	6 Oil field water supply
2 Irrigation	4 Industrial	7 Lawn and garden only
		10 <u>Monitoring well</u>

Was a chemical/bacteriological sample submitted to Department? Yes \_\_\_\_\_ No X If yes, mo/day/yr sample was submitted \_\_\_\_\_

Water Well Disinfected? Yes \_\_\_\_\_ No X

5] TYPE OF BLANK CASING USED:

1 Steel	3 RMP (SR)	5 Wrought iron	8 Concrete tile	CASING JOINTS: Glued _____ Clamped _____
2 <u>PVC</u>	4 <u>ABS</u>	6 Asbestos-Cement	9 Other (specify below)	Welded _____
		7 Fiberglass		Threaded <u>X</u>

Blank casing diameter: 2 in. to 38 ft., Dia \_\_\_\_\_ in. to \_\_\_\_\_ ft., Dia \_\_\_\_\_ in. to \_\_\_\_\_ ft.

Casing height above land surface: 0 in., weight 716 lbs./ft. Wall thickness or gauge No. 154

TYPE OF SCREEN OR PERFORATION MATERIAL:

1 Steel	3 Stainless steel	5 Fiberglass	7 <u>PVC</u>	10 Asbestos-cement
2 Brass	4 Galvanized steel	6 Concrete tile	8 RMP (SR)	11 Other (specify)
			9 ABS	12 None used (open hole)

SCREEN OR PERFORATION OPENINGS ARE:

1 Continuous slot	3 Mill slot	5 Gauzed wrapped	8 <u>Saw cut</u>	11 None (open hole)
2 Louvered shutter	4 Key punched	6 Wire wrapped	9 Drilled holes	
		7 Torch cut	10 Other (specify)	

SCREEN-PERFORATED INTERVALS: From \_\_\_\_\_ ft. to \_\_\_\_\_ ft., From \_\_\_\_\_ ft. to \_\_\_\_\_ ft.

GRAVEL PACK INTERVALS: From 36 ft. to 39.5 ft., From \_\_\_\_\_ ft. to \_\_\_\_\_ ft.

6] GROUT MATERIAL: 1 Neat cement 2 Cement grout 3 Bentonite 4 Other \_\_\_\_\_

Grout Intervals: From 0 ft. to 34 ft., From 34 ft. to 36 ft., From \_\_\_\_\_ ft. to \_\_\_\_\_ ft.

What is the nearest source of possible contamination:

1 Septic tank	4 Lateral lines	7 Pit privy	10 Livestock pens	14 Abandoned water well
2 Sewer lines	5 Cess pool	8 Sewage lagoon	11 Fuel storage	15 Oil well/Gas well
3 Watertight sewer lines	6 Seepage pit	9 Feedyard	12 Fertilizer storage	16 Other (specify below)

Direction from well? \_\_\_\_\_ How many feet? \_\_\_\_\_

*Contaminated site*

FROM	TO	LITHOLOGIC LOG	FROM	TO	PLUGGING INTERVALS
0	32	Brown clayey silt			
32	36	Clayey silt w/ fine sand			
36	39.5	fine to med clayey sand			

7] CONTRACTOR'S OR LANDOWNER'S CERTIFICATION: This water well was (1) constructed, (2) reconstructed, or (3) plugged under my jurisdiction and was completed on (mo/day/year) 9-22-98 and this record is true to the best of my knowledge and belief. Kansas Water Well Contractor's License No. 554 This Water Well Record was completed on (mo/day/yr) 3-2-99 under the business name of Woofler Pumps Well, Inc by signature [Signature]

INSTRUCTIONS: Use typewriter or ball point pen. PLEASE PRESS FIRMLY and PRINT clearly. Please fill in blanks, underline or circle the correct answers. Send top three copies to Kansas Department of Health and Environment, Bureau of Water, Topeka, Kansas 66620-0001. Telephone: 913-296-5545. Send one to WATER WELL OWNER and retain one for your records.

OFFICE USE ONLY T R E W SEC. 1/4 1/4 1/4