


1] LOCATION OF WATER WELL: County: NESS, Fraction: NW 1/4 SW 1/4 SW 1/4, Section Number: 30, Township Number: T 18 S, Range Number: R 23 EW

2] WATER WELL OWNER: Westside Service, RR#, St. Address, Box #: 918 W. Sycamore St., City, State, ZIP Code: Ness City, Ks 67560, Board of Agriculture, Division of Water Resources, Application Number: SV7

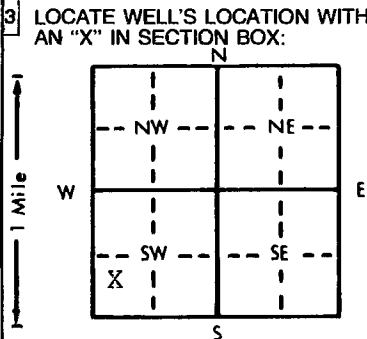

4] DEPTH OF COMPLETED WELL: 38.0 ft. ELEVATION: ... WELL'S STATIC WATER LEVEL: 33.8 ft. below land surface measured on mo/day/yr ... Pump test data: Well water was ... ft. after ... hours pumping ... gpm ... Est. Yield ... gpm: Well water was ... ft. after ... hours pumping ... gpm ... Bore Hole Diameter: 8 in. to 38.0 ft., and ... in. to ... ft. ... WELL WATER TO BE USED AS: 5 Public water supply, 8 Air conditioning, 11 Injection well, 12 Other (Specify below) ... Was a chemical/bacteriological sample submitted to Department? Yes No X; If yes, mo/day/yr sample was submitted Water Well Disinfected? Yes No X

5] TYPE OF BLANK CASING USED: 1 Steel, 3 RMP (SR), 2 PVC, 4 ABS, 5 Wrought iron, 8 Concrete tile, 6 Asbestos-Cement, 9 Other (specify below), 7 Fiberglass, CASING JOINTS: Glued, Clamped, Welded, Threaded, X ... Blank casing diameter: 2 in. to 23.0 ft., Dia ... in. to ... ft., Dia ... in. to ... ft. ... Casing height above land surface: 0 in., weight .716 lbs./ft. Wall thickness or gauge No. 154 ... TYPE OF SCREEN OR PERFORATION MATERIAL: 1 Steel, 3 Stainless steel, 5 Fiberglass, 7 PVC, 10 Asbestos-cement, 2 Brass, 4 Galvanized steel, 6 Concrete tile, 8 RMP (SR), 11 Other (specify) ... 12 None used (open hole) ... SCREEN OR PERFORATION OPENINGS ARE: 1 Continuous slot, 3 Mill slot, 5 Gauzed wrapped, 8 Saw cut, 11 None (open hole), 2 Louvered shutter, 4 Key punched, 6 Wire wrapped, 9 Drilled holes, 7 Torch cut, 10 Other (specify) ... SCREEN-PERFORATED INTERVALS: From 23.0 ft. to 38.0 ft., From ... ft. to ... ft., From ... ft. to ... ft. ... GRAVEL PACK INTERVALS: From 21.0 ft. to 38.0 ft., From ... ft. to ... ft., From ... ft. to ... ft.

6] GROUT MATERIAL: 1 Neat cement, 2 Cement grout, 3 Bentonite, 4 Other ... Grout Intervals: From 0 ft. to 19.0 ft., From 19.0 ft. to 21.0 ft., From ... ft. to ... ft. ... What is the nearest source of possible contamination: 1 Septic tank, 4 Lateral lines, 7 Pit privy, 10 Livestock pens, 14 Abandoned water well, 2 Sewer lines, 5 Cess pool, 8 Sewage lagoon, 11 Fuel storage, 15 Oil well/Gas well, 3 Watertight sewer lines, 6 Seepage pit, 9 Feedyard, 12 Fertilizer storage, 16 Other (specify below), 13 Insecticide storage, Contaminated Storage ... Direction from well? How many feet?

Table with columns: FROM, TO, LITHOLOGIC LOG, FROM, TO, PLUGGING INTERVALS. Row 1: 0, 35, Brown clayey silt, dry. Row 2: 35, 38, Black, very stained clayey silt, wet.

7] CONTRACTOR'S OR LANDOWNER'S CERTIFICATION: This water well was (1) constructed, (2) reconstructed, or (3) plugged under my jurisdiction and was completed on (mo/day/year) 9-22-98 and this record is true to the best of my knowledge and belief. Kansas Water Well Contractor's License No. 554 This Water Well Record was completed on (mo/day/yr) 3-2-99 under the business name of Woofter Pump & Well Inc. by (signature) Jay C. Woofter

INSTRUCTIONS: Use typewriter or ball point pen. PLEASE PRESS FIRMLY and PRINT clearly. Please fill in blanks, underline or circle the correct answers. Send top three copies to Kansas Department of Health and Environment, Bureau of Water, Topeka, Kansas 66620-0001. Telephone: 913-296-5545. Send one to WATER WELL OWNER and retain one for your records.