


1 LOCATION OF WATER WELL: County: NESS Fraction: NW 1/4 SW 1/4 SW 1/4 Section Number: 30 Township Number: T 18 S Range Number: R 23 EW

Distance and direction from nearest town or city street address of well if located within city?

2 WATER WELL OWNER: Westside Service RR#, St. Address, Box #: 918 W. Sycamore St. City, State, ZIP Code: Ness City, Ks 67560 Board of Agriculture, Division of Water Resources SV-8 Application Number:

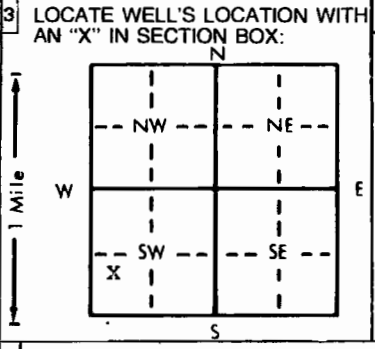

3 LOCATE WELL'S LOCATION WITH AN 'X' IN SECTION BOX: 4 DEPTH OF COMPLETED WELL: 38.0 ft. ELEVATION: WELL'S STATIC WATER LEVEL: 33.3 ft. below land surface measured on mo/day/yr Pump test data: Well water was ... ft. after ... hours pumping ... gpm Est. Yield ... gpm: Well water was ... ft. after ... hours pumping ... gpm Bore Hole Diameter ... in. to ... ft., and ... in. to ... ft. WELL WATER TO BE USED AS: 5 Public water supply 8 Air conditioning 11 Injection well 1 Domestic 3 Feedlot 6 Oil field water supply 9 Dewatering 12 Other (Specify below) 2 Irrigation 4 Industrial 7 Lawn and garden only 10 Monitoring well Was a chemical/bacteriological sample submitted to Department? Yes ... No ... X ... If yes, mo/day/yr sample was submitted Water Well Disinfected? Yes No X

5 TYPE OF BLANK CASING USED: 1 Steel 3 RMP (SR) 2 PVC 4 ABS Blank casing diameter: 2 in. to 23.0 ft., Dia. in. to ... ft., Dia. in. to ... ft. Casing height above land surface: 0 in., weight: 7.16 lbs./ft. Wall thickness or gauge No.: 154

TYPE OF SCREEN OR PERFORATION MATERIAL: 1 Steel 3 Stainless steel 5 Fiberglass 8 RMP (SR) 2 Brass 4 Galvanized steel 6 Concrete tile 9 ABS 10 Asbestos-cement 11 Other (specify) 12 None used (open hole)

SCREEN OR PERFORATION OPENINGS ARE: 1 Continuous slot 3 Mill slot 5 Gauzed wrapped 8 Saw cut 2 Louvered shutter 4 Key punched 6 Wire wrapped 9 Drilled holes 7 Torch cut 10 Other (specify) 11 None (open hole)

SCREEN-PERFORATED INTERVALS: From 23.0 ft. to 38.0 ft. GRAVEL PACK INTERVALS: From 21.0 ft. to 38.0 ft.

6 GROUT MATERIAL: 1 Neat cement 2 Cement grout 3 Bentonite 4 Other Grout Intervals: From 0 ft. to 19.0 ft., From 19.0 ft. to 21.0 ft. What is the nearest source of possible contamination: 1 Septic tank 4 Lateral lines 7 Pit privy 10 Livestock pens 14 Abandoned water well 2 Sewer lines 5 Cess pool 8 Sewage lagoon 11 Fuel storage 15 Oil well/Gas well 3 Watertight sewer lines 6 Seepage pit 9 Feedyard 12 Fertilizer storage 16 Other (specify below) 13 Insecticide storage Contaminated Site

Direction from well? How many feet? FROM TO LITHOLOGIC LOG FROM TO PLUGGING INTERVALS

0	35	Brown clayey silt, dry			
35	38	Silty clay, black staining			

7 CONTRACTOR'S OR LANDOWNER'S CERTIFICATION: This water well was (1) constructed, (2) reconstructed, or (3) plugged under my jurisdiction and was completed on (mo/day/year) 9-22-98 and this record is true to the best of my knowledge and belief. Kansas Water Well Contractor's License No. 554 This Water Well Record was completed on (mo/day/yr) 3-2-99 under the business name of Woofter Pump & Well Inc. by (signature) Jay G. Woofter

OFFICE USE ONLY T R EW SEC 1/4 1/4