


1 LOCATION OF WATER WELL: Fraction NE 1/4 SE 1/4 SW 1/4 Section Number 30 Township Number T 18 S Range Number R 23 E (W)  
 County: Ness

Distance and direction from nearest town or city street address of well if located within city?  
Main & Court Street, Ness City, KS.

2 WATER WELL OWNER: Right Coop  
 RR#, St. Address, Box #: Main & Court St. Board of Agriculture, Division of Water Resources  
 City, State, ZIP Code: Ness City, KS. Application Number:

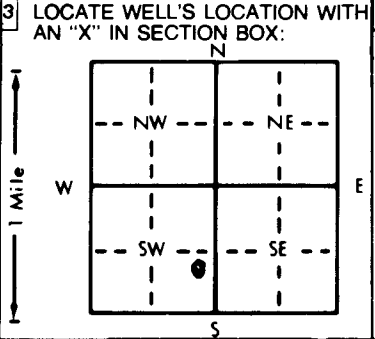

4 DEPTH OF COMPLETED WELL: 42' ft. ELEVATION:  
 Depth(s) Groundwater Encountered 1 34' ft. 2. .... ft. 3. .... ft.  
 WELL'S STATIC WATER LEVEL 33.72' ft. below land surface measured on mo/day/yr 4-20-99  
 Pump test data: Well water was ..... ft. after ..... hours pumping ..... gpm  
 Est. Yield ..... gpm Well water was ..... ft. after ..... hours pumping ..... gpm  
 Bore Hole Diameter: 8 1/2" in. to 42" ft. and ..... in. to ..... ft.  
 WELL WATER TO BE USED AS:  
 1 Domestic 3 Feedlot 6 Oil field water supply 8 Air conditioning 11 Injection well  
 2 Irrigation 4 Industrial 7 Lawn and garden only 10 Monitoring well 12 Other (Specify below)  
 Was a chemical/bacteriological sample submitted to Department? Yes ..... No X ..... If yes, mo/day/yr sample was submitted  
 Water Well Disinfected? Yes ..... No (No)

5 TYPE OF BLANK CASING USED:  
 1 Steel 3 RMP (SR) 5 Wrought iron 8 Concrete tile CASING JOINTS: Glued ..... Clamped .....  
2 PVC 4 ABS 6 Asbestos-Cement 9 Other (specify below) Welded .....  
 7 Fiberglass Threaded X  
 Blank casing diameter 2.375 in. to 27 ft. Dia ..... in. to ..... ft. Dia ..... in. to SDR 13 ft.  
 Casing height above land surface FLUSH Mt. in., weight ..... lbs./ft. Wall thickness or gauge No. SCE 40  
 TYPE OF SCREEN OR PERFORATION MATERIAL:  
 1 Steel 3 Stainless steel 5 Fiberglass 8 RMP (SR) 10 Asbestos-cement  
 2 Brass 4 Galvanized steel 6 Concrete tile 9 ABS 11 Other (specify) .....  
 12 None used (open hole)  
 SCREEN OR PERFORATION OPENINGS ARE:  
 1 Continuous slot 3 Mill slot 5 Gauzed wrapped 8 Saw cut 11 None (open hole)  
 2 Louvered shutter 4 Key punched 6 Wire wrapped 9 Drilled holes  
 7 Torch cut 10 Other (specify) .....  
 SCREEN-PERFORATED INTERVALS: From 42' ft. to 27' ft. From ..... ft. to ..... ft.  
 From ..... ft. to ..... ft. From ..... ft. to ..... ft.  
 GRAVEL PACK INTERVALS: From 42' ft. to 25' ft. From ..... ft. to ..... ft.  
 From ..... ft. to ..... ft. From ..... ft. to ..... ft.

6 GROUT MATERIAL: 1 Neat cement 2 Cement grout 3 Bentonite 4 Other .....  
 Grout Intervals: From 25' ft. to 3' ft. From 3' ft. to 0' ft. From ..... ft. to ..... ft.  
 What is the nearest source of possible contamination:  
 1 Septic tank 4 Lateral lines 7 Pit privy 11 Fuel storage Fourel 14 Abandoned water well  
 2 Sewer lines 5 Cess pool 8 Sewage lagoon 12 Fertilizer storage 15 Oil well/Gas well  
 3 Watertight sewer lines 6 Seepage pit 9 Feedyard 13 Insecticide storage 16 Other (specify below)  
 Direction from well? in old pit How many feet? 0'

FROM	TO	LITHOLOGIC LOG	FROM	TO	PLUGGING INTERVALS
0	9	Silty clay w/ sand, brn-lt brn, moist, friable, coal frag., fill material.			
9	10	Sand, backfill, dry,			
10	28	Clayey silt, lt. brn-tan, friable, slightly moist.			
28	35	Sand, lt brn-lt gray, slightly moist, fine-coarse, strong odor.			
35	39	Clayey silt, lt brn-tan, wet, slightly clayey, strong odor.			
39	42	Sand, wet, coarse, gravelly, some pebbles, stained dk gray.			
					Fl. Mt. OK'D by Don Taylor

7 CONTRACTOR'S OR LANDOWNER'S CERTIFICATION: This water well was (1) constructed, (2) reconstructed, or (3) plugged under my jurisdiction and was completed on (mo/day/year) 4-20-99 and this record is true to the best of my knowledge and belief. Kansas Water Well Contractor's License No. 539 This Water Well Record was completed on (mo/day/yr) 6-23-99 under the business name of JB Environmental Drilling by (signature) James Buebel

OFFICE USE ONLY  
T  
R  
EM  
SEC.  
1/4  
1/4  
1/4