


1 LOCATION OF WATER WELL: Fraction NE 1/4 SE 1/4 SW 1/4 Section Number 30 Township Number T 18 S Range Number R 23 E

Distance and direction from nearest town or city street address of well if located within city?

Main & Court Street, Ness City, KS.

2 WATER WELL OWNER: Right Coop
 RR#, St. Address, Box #: Main & Court St. Board of Agriculture, Division of Water Resources
 City, State, ZIP Code: Ness City, KS. Application Number:

3 LOCATE WELL'S LOCATION WITH AN "X" IN SECTION BOX:

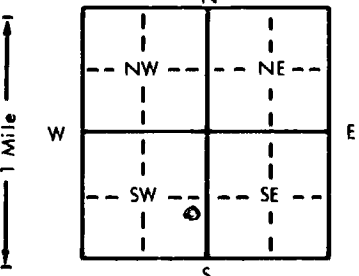

4 DEPTH OF COMPLETED WELL... 42' ft. ELEVATION:
 Depth(s) Groundwater Encountered 1.33' ft. 2. ft. 3. ft.
 WELL'S STATIC WATER LEVEL 32.43 ft. below land surface measured on mo/day/yr 4-21-99
 Pump test data: Well water was ft. after hours pumping gpm
 Est. Yield gpm; Well water was ft. after hours pumping gpm
 Bore Hole Diameter... 8 1/2 in. to 42' ft., and in. to ft.
 WELL WATER TO BE USED AS: 5 Public water supply 8 Air conditioning 11 Injection well
 1 Domestic 3 Feedlot 6 Oil field water supply 9 Dewatering 12 Other (Specify below)
 2 Irrigation 4 Industrial 7 Lawn and garden only 10 Monitoring well
 Was a chemical/bacteriological sample submitted to Department? Yes.....No. X.....; If yes, mo/day/yr sample was sub-
 mitted Water Well Disinfected? Yes No

5 TYPE OF BLANK CASING USED: 1 Steel 3 RMP (SR) 5 Wrought iron 8 Concrete tile CASING JOINTS: Glued Clamped
2 PVC 4 ABS 6 Asbestos-Cement 9 Other (specify below) Welded
 Blank casing diameter 2.375 in. to 27' ft., Dia in. to ft., Dia in. to SDR 13 ft.
 Casing height above land surface Flush ML in., weight lbs./ft. Wall thickness or gauge No. SC 40
 TYPE OF SCREEN OR PERFORATION MATERIAL: 7 PVC 10 Asbestos-cement
 1 Steel 3 Stainless steel 5 Fiberglass 8 RMP (SR) 11 Other (specify)
 2 Brass 4 Galvanized steel 6 Concrete tile 9 ABS 12 None used (open hole)
 SCREEN OR PERFORATION OPENINGS ARE: 5 Gauzed wrapped 8 Saw cut 11 None (open hole)
 1 Continuous slot 3 Mill slot 6 Wire wrapped 9 Drilled holes
 2 Louvered shutter 4 Key punched 7 Torch cut 10 Other (specify)
 SCREEN-PERFORATED INTERVALS: From 42' ft. to 27' ft., From ft. to ft.
 GRAVEL PACK INTERVALS: From 42' ft. to 25' ft., From ft. to ft.

6 GROUT MATERIAL: 1 Neat cement 2 Cement grout 3 Bentonite 4 Other
 Grout Intervals: From 25' ft. to 3' ft., From 3' ft. to 0' ft., From ft. to ft.
 What is the nearest source of possible contamination: 1 Septic tank 4 Lateral lines 7 Pit privy 10 Livestock pens 14 Abandoned water well
 2 Sewer lines 5 Cess pool 8 Sewage lagoon 11 Fuel storage FOUML 15 Oil well/Gas well
 3 Watertight sewer lines 6 Seepage pit 9 Feedyard 12 Fertilizer storage 16 Other (specify below)
 Direction from well? Northwest How many feet? 35'

| FROM | TO | LITHOLOGIC LOG | FROM | TO | PLUGGING INTERVALS |
|------|----|--|------|----|----------------------------|
| 0 | 3 | Silty clay, dk brn-brn, dry, hard. | | | |
| 3 | 29 | Clayey silt, lt brn, dry, hard. some caliche, firm. Bottom 6" discolored gray. | | | |
| 29 | 37 | Sand, gray-lt gray, moist- wet at 34', fine grained, gravelly, trace odor. | | | |
| 37 | 40 | Silty clay, brn-olive brn, wet, caliche, very strong odor. | | | |
| 40 | 42 | Sand, fine-coarse, wet. some caliche & gravel, very strong odor. | | | |
| | | | | | Fl. Mt. OK'D by Don Taylor |

7 CONTRACTOR'S OR LANDOWNER'S CERTIFICATION: This water well was (1) constructed (2) reconstructed, or (3) plugged under my jurisdiction and was completed on (mo/day/year) 4-21-99 and this record is true to the best of my knowledge and belief. Kansas Water Well Contractor's License No. 539 This Water Well Record was completed on (mo/day/yr) 6-23-99 under the business name of JB Environmental Drilling by signature James Belk

INSTRUCTIONS: Use typewriter or ball point pen. PLEASE PRESS FIRMLY and PRINT clearly. Please fill in blanks, underline or circle the correct answers. Send top three copies to Kansas Department of Health and Environment, Bureau of Water, Topeka, Kansas 66620-0001. Telephone: 913-296-5545. Send one to WATER WELL OWNER and retain one for your records.

OFFICE USE ONLY T R E W SEC. 1/4 1/4 1/4 1/4