


1 LOCATION OF WATER WELL: County: Ness Fraction: SE 1/4 NW 1/4 NE 1/4 Section Number: 31 Township Number: T 18 S Range Number: R 23 E/W

Distance and direction from nearest town or city street address of well if located within city?
520 South Penn., Ness City, KS.

2 WATER WELL OWNER: Home Oil #2 & Harold Gabel
 RR#, St. Address, Box #: 302 W. Sycamore
 City, State, ZIP Code: Ness City, Ks.
 Board of Agriculture, Division of Water Resources
 Application Number:

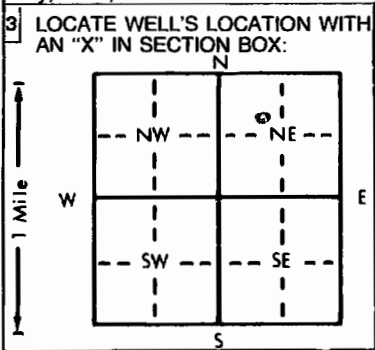

4 DEPTH OF COMPLETED WELL: 45' ft. ELEVATION: _____ ft.
 Depth(s) Groundwater Encountered: 1. 34 ft. 2. _____ ft. 3. _____ ft.
 WELL'S STATIC WATER LEVEL: 33.98 ft. below land surface measured on mo/day/yr 1-31-00
 Pump test data: Well water was _____ ft. after _____ hours pumping _____ gpm
 Est. Yield _____ gpm Well water was _____ ft. after _____ hours pumping _____ gpm
 Bore Hole Diameter: 8 1/2" in. to 45' ft., and _____ in. to _____ ft.
 WELL WATER TO BE USED AS:
 5 Public water supply 8 Air conditioning 11 Injection well
 1 Domestic 3 Feedlot 6 Oil field water supply 9 Dewatering
 2 Irrigation 4 Industrial 7 Lawn and garden only 10 Monitoring well Air Sparge
 Was a chemical/bacteriological sample submitted to Department? Yes _____ No X; If yes, mo/day/yr sample was submitted _____
 Water Well Disinfected? Yes _____ No (No)

5 TYPE OF BLANK CASING USED:
 1 Steel 3 RMP (SR) 5 Wrought iron 8 Concrete tile CASING JOINTS: Glued _____ Clamped _____
2 PVC 4 ABS 6 Asbestos-Cement 9 Other (specify below) Welded _____
 7 Fiberglass Threaded _____
 Blank casing diameter: 2.375 in. to 42' ft., Dia _____ in. to _____ ft., Dia _____ in. to _____ ft. SDR 13
 Casing height above land surface: FLUSH ML in., weight _____ lbs./ft. Wall thickness or gauge No. Sch 40
 TYPE OF SCREEN OR PERFORATION MATERIAL:
 1 Steel 3 Stainless steel 5 Fiberglass 8 RMP (SR) 11 Other (specify) _____
 2 Brass 4 Galvanized steel 6 Concrete tile 9 ABS 12 None used (open hole)
 SCREEN OR PERFORATION OPENINGS ARE:
 1 Continuous slot 3 Mill slot 5 Gauzed wrapped 8 Saw cut 11 None (open hole)
 2 Louvered shutter 4 Key punched 6 Wire wrapped 9 Drilled holes
 7 Torch cut 10 Other (specify) _____
 SCREEN-PERFORATED INTERVALS: From 45' ft. to 42' ft., From _____ ft. to _____ ft.
 From _____ ft. to _____ ft., From _____ ft. to _____ ft.
 GRAVEL PACK INTERVALS: From 45' ft. to 40' ft., From _____ ft. to _____ ft.
 From _____ ft. to _____ ft., From _____ ft. to _____ ft.

6 GROUT MATERIAL: 1 Neat cement 2 Cement grout 3 Cement 4 Other _____
 Grout Intervals: From 40' ft. to 3' ft., From _____ ft. to _____ ft., From _____ ft. to _____ ft.
 What is the nearest source of possible contamination:
 1 Septic tank 4 Lateral lines 7 Pit privy 10 Livestock pens 14 Abandoned water well
 2 Sewer lines 5 Cess pool 8 Sewage lagoon 11 Fuel storage 15 Oil well/Gas well
 3 Watertight sewer lines 6 Seepage pit 9 Feedyard 12 Fertilizer storage 16 Other (specify below) _____
 13 Insecticide storage _____
 Direction from well? Northeast How many feet? 100'

FROM	TO	LITHOLOGIC LOG	FROM	TO	PLUGGING INTERVALS
0	1.25	Concrete over sand.			
1.25	10.5	Blk to dk brn clay, firm, moist.			
10.5	20	Lt-med brn silty clay, stiff, moist to dry, trace of caliche.			
20	24	Lt brn sandy clay to clayey sand, moist, faint odor.			
24	27.5	Olive green sandy clay to clayey sand, mod. odor, moist-wet.			
27.5	35	Lt gray white clayey sand, odor, fine-med, moist-wet.			
35	44	Gray fine-coarse sand & gravel, wet, mod. odor, poorly sorted.			
44	45	Brn clay, moist, no odor.			

7 CONTRACTOR'S OR LANDOWNER'S CERTIFICATION: This water well was (1) constructed, (2) reconstructed, or (3) plugged under my jurisdiction and was completed on (mo/day/year) 11-3-99 and this record is true to the best of my knowledge and belief. Kansas Water Well Contractor's License No. 539 This Water Well Record was completed on (mo/day/yr) 2-14-00 under the business name of JB Environmental Drilling by signature James Becker

INSTRUCTIONS: Use typewriter or ball point pen. PLEASE PRESS FIRMLY and PRINT clearly. Please fill in blanks, underline or circle the correct answers. Send top three copies to Kansas Department of Health and Environment, Bureau of Water, Topeka, Kansas 66620-0001. Telephone: 913-296-5545. Send one to WATER WELL OWNER and retain one for your records.

OFFICE USE ONLY
T
R
E
W
SEC.