


1 LOCATION OF WATER WELL: Fraction SE 1/4 NW 1/4 NE 1/4 Section Number 31 Township Number T 18 S Range Number R 23 E(W)  
 County: Ness

Distance and direction from nearest town or city street address of well if located within city?  
520 South Penn., Ness City, KS.

2 WATER WELL OWNER: Home Oil #2 & Harold Gabel  
 RR#, St. Address, Box #: 302 W. Sycamore Board of Agriculture, Division of Water Resources  
 City, State, ZIP Code: Ness City, Ks. Application Number:

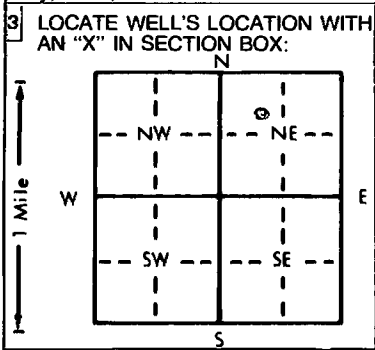

4 DEPTH OF COMPLETED WELL: 45' ft. ELEVATION:  
 Depth(s) Groundwater Encountered 1.34 ft. 2. . . . . ft. 3. . . . . ft.  
 WELL'S STATIC WATER LEVEL 34.10 ft. below land surface measured on mo/day/yr 1-31-00  
 Pump test data: Well water was . . . . . ft. after . . . . . hours pumping . . . . . gpm  
 Est. Yield . . . . . gpm; Well water was . . . . . ft. after . . . . . hours pumping . . . . . gpm  
 Bore Hole Diameter: 8 1/2" in. to 45' . . . . . ft., and . . . . . in. to . . . . . ft.  
 WELL WATER TO BE USED AS: 5 Public water supply 8 Air conditioning 11 Injection well  
 1 Domestic 3 Feedlot 6 Oil field water supply 9 Dewatering 12 Other (Specify below)  
 2 Irrigation 4 Industrial 7 Lawn and garden only 10 Monitoring well Air Sparge  
 Was a chemical/bacteriological sample submitted to Department? Yes . . . . . No X . . . . . If yes, mo/day/yr sample was submitted  
 Water Well Disinfected? Yes No

5 TYPE OF BLANK CASING USED: 5 Wrought iron 8 Concrete tile CASING JOINTS: Glued . . . . . Clamped . . . . .  
 1 Steel 3 RMP (SR) 6 Asbestos-Cement 9 Other (specify below) Welded . . . . .  
2 PVC 4 ABS 7 Fiberglass . . . . . Threaded . . . . .  
 Blank casing diameter 2.375 in. to 42' . . . . . ft., Dia . . . . . in. to . . . . . ft., Dia . . . . . in. to SDR 13 . . . . . ft.  
 Casing height above land surface FLUSH in., weight . . . . . lbs./ft. Wall thickness or gauge No. Sch 40  
 TYPE OF SCREEN OR PERFORATION MATERIAL: 7 PVC 10 Asbestos-cement  
 1 Steel 3 Stainless steel 5 Fiberglass 8 RMP (SR) 11 Other (specify) . . . . .  
 2 Brass 4 Galvanized steel 6 Concrete tile 9 ABS 12 None used (open hole)  
 SCREEN OR PERFORATION OPENINGS ARE: 5 Gauzed wrapped 8 Saw cut 11 None (open hole)  
 1 Continuous slot 3 Mill slot 6 Wire wrapped 9 Drilled holes  
 2 Louvered shutter 4 Key punched 7 Torch cut 10 Other (specify) . . . . .  
 SCREEN-PERFORATED INTERVALS: From 45' ft. to 42' . . . . . ft., From . . . . . ft. to . . . . . ft.  
 From . . . . . ft. to . . . . . ft., From . . . . . ft. to . . . . . ft.  
 GRAVEL PACK INTERVALS: From 45 ft. to 40 . . . . . ft., From . . . . . ft. to . . . . . ft.  
 From . . . . . ft. to . . . . . ft., From . . . . . ft. to . . . . . ft.

6 GROUT MATERIAL: 1 Neat cement 2 Cement grout 3 Bentonite 4 Other . . . . .  
 Grout Intervals: From 40' ft. to 33' ft. From 33' ft. to 3' ft. From . . . . . ft. to . . . . . ft.  
 What is the nearest source of possible contamination: 10 Livestock pens 14 Abandoned water well  
 1 Septic tank 4 Lateral lines 7 Pit privy 11 Fuel storage 15 Oil well/Gas well  
 2 Sewer lines 5 Cess pool 8 Sewage lagoon 12 Fertilizer storage 16 Other (specify below)  
 3 Watertight sewer lines 6 Seepage pit 9 Feedyard 13 Insecticide storage  
 Direction from well? EAD How many feet? 25'

FROM	TO	LITHOLOGIC LOG	FROM	TO	PLUGGING INTERVALS
0	1	6" concrete over sand backfill			
1	15	Brn-dk brn clay, dry-damp, no odor, stiff to tight.			
15	22	Lt brn silty clay, moist, firm, no odor.			
22	32	Brn sandy clay to clayey sand, fine-med, moist, no odor.			
32	35	Brn. fine-coarse sand & gravel, wet, slight odor.			
35	44	white, mod. odor, wet.			Fl mts. ck'd by Don Taylor
44	45	Brn clay, tight, moist, no odor.			

7 CONTRACTOR'S OR LANDOWNER'S CERTIFICATION: This water well was (1) constructed (2) reconstructed, or (3) plugged under my jurisdiction and was completed on (mo/day/year) 11-2-99 and this record is true to the best of my knowledge and belief. Kansas Water Well Contractor's License No. 539 This Water Well Record was completed on (mo/day/yr) 2-14-00 under the business name of JB Environmental Drilling by (signature) James Beebe

OFFICE USE ONLY  
T  
R  
EW  
SEC.  
1/4  
1/4  
1/4