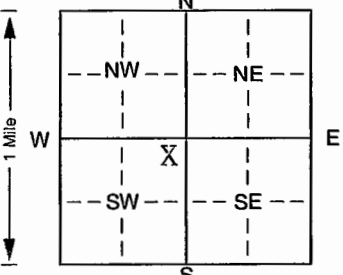


1 LOCATION OF WATER WELL: Fraction NE 1/4 NE 1/4 SW 1/4 Section Number 30 Township Number T 18 S Range Number R 23 EW
 County: Ness

Distance and direction from nearest town or city street address of well if located within city?
519 W. Chestnut Ness City, KS

2 WATER WELL OWNER: Larry Benedict
 RR#, St. Address, Box # : 519 W. Chestnut Board of Agriculture, Division of Water Resources
 City, State, ZIP Code : Ness City, KS 67560 Application Number:

3 LOCATE WELL'S LOCATION WITH AN "X" IN SECTION BOX:


4 DEPTH OF COMPLETED WELL 58 ft. ELEVATION:
 Depth(s) Groundwater Encountered 1. 34 ft. 2. 7-31-02 ft. 3. 02 ft.
 WELL'S STATIC WATER LEVEL 34 ft. below land surface measured on mo/day/yr
 Pump test data: Well water was NA ft. after NA hours pumping NA gpm
 Est. Yield NA gpm: Well water was NA ft. after NA hours pumping NA gpm
 Bore Hole Diameter 9 in. to 58 ft., and NA in. to NA ft.
 WELL WATER TO BE USED AS: 5 Public water supply 8 Air conditioning 11 Injection well
 1 Domestic 3 Feedlot 6 Oil field water supply 9 Dewatering 12 Other (Specify below)
 2 Irrigation 4 Industrial 7 Domestic (lawn & garden) 10 Monitoring well
 Was a chemical/bacteriological sample submitted to Department? Yes. NA No. X; If yes, mo/day/yrs sample was submitted
 Water Well Disinfected? Yes NA No X

5 TYPE OF BLANK CASING USED: 5 Wrought iron 8 Concrete tile CASING JOINTS: Glued X Clamped NA
 1 Steel 3 RMP (SR) 6 Asbestos-Cement 9 Other (specify below) Welded NA
 2 PVC 4 ABS 7 Fiberglass Threaded NA
 Blank casing diameter 5 in. to 48 ft., Dia NA in. to NA ft., Dia NA in. to NA ft.
 Casing height above land surface 24 in., weight SDR-26 lbs./ft. Wall thickness or gauge No. NA
 TYPE OF SCREEN OR PERFORATION MATERIAL: 7 PVC 10 Asbestos-cement
 1 Steel 3 Stainless steel 5 Fiberglass 8 RMP (SR) 11 Other (specify) NA
 2 Brass 4 Galvanized steel 6 Concrete tile 9 ABS 12 None used (open hole)
 SCREEN OR PERFORATION OPENINGS ARE: 5 Gauzed wrapped 8 Saw cut 11 None (open hole)
 1 Continuous slot 3 Mill slot 6 Wire wrapped 9 Drilled holes
 2 Louvered shutter 4 Key punched 7 Torch cut 10 Other (specify) NA ft.
 SCREEN-PERFORATED INTERVALS: From 58 ft. to 48 ft., From NA ft. to NA ft.
 From NA ft. to NA ft., From NA ft. to NA ft.
 GRAVEL PACK INTERVALS: From 58 ft. to 20 ft., From NA ft. to NA ft.
 From NA ft. to NA ft., From NA ft. to NA ft.

6 GROUT MATERIAL: 1 Neat cement 2 Cement grout 3 Bentonite 4 Other hole plug
 Grout Intervals: From 20 ft. to 0 ft., From NA ft. to NA ft., From NA ft. to NA ft.
 What is the nearest source of possible contamination:
 1 Septic tank 4 Lateral lines 7 Pit privy 10 Livestock pens 14 Abandoned water well
 2 Sewer lines 5 Cess pool 8 Sewage lagoon 11 Fuel storage 15 Oil well/Gas well
 3 Watertight sewer lines 6 Seepage pit 9 Feedyard 12 Fertilizer storage 16 Other (specify below) House
 Direction from well? East How many feet? 15 ft.

FROM	TO	LITHOLOGIC LOG	FROM	TO	PLUGGING INTERVALS
0	3	top soil			
3	41	silty brown clay			
41	52	fine sand and sandy black brown clay			
52	53 1/2	gray clay, tough			
53 1/2	57	sand and gravel clean, loose, small, with clay streaks			
57	58	black kiowa shale			

7 CONTRACTOR'S OR LANDOWNER'S CERTIFICATION: This water well was (1) constructed, (2) reconstructed, or (3) plugged under my jurisdiction and was completed on (mo/day/year) 7-31-02 and this record is true to the best of my knowledge and belief. Kansas Water Well Contractor's Licence No. 134 This Water Well Record was completed on (mo/day/yr) 8-8-02 under the business name of Rosenkrantz-Bemis by (signature) Meddie Madson