


1 LOCATION OF WATER WELL: Fraction Section Number Township Number Range Number
 County: Ness NW 1/4 SW 1/4 SE 1/4 30 18 73W

Distance and direction from nearest town or city street address of well if located within city?
NORTH SIDE SYCAMORE ST., BETWEEN KANSAS AVE. AND COURT ST.

2 WATER WELL OWNER: HAROLD LABLE
 RR #, St. Address, Box #: 301 W. SYCAMORE
 City, State, ZIP Code: NESS CITY, KS. 66560
 Board of Agriculture, Division of Water Resources Application Number:

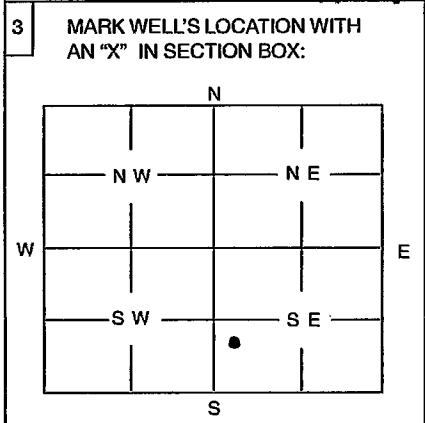

4 DEPTH OF WELL 34 ft
 WELL'S STATIC WATER LEVEL 37.75 ft
 WELL WAS USED AS:
 1 Domestic 5 Public Water Supply 9 Dewatering
 2 Irrigation 6 Oil Field Water Supply 10 Monitoring Well
 3 Feedlot 7 Domestic (Lawn & Garden) 11 Injection Well
 4 Industrial 8 Air Conditioning 12 Other
 Was a chemical / bacteriological sample submitted to Department? Yes No
 If yes, mo/day/yr sample was submitted N/A
 Water Well Disinfected: Yes No

5 TYPE OF BLANK CASING USED:
 1 Steel 3 RMP (SR) 5 Wrought 7 Fiberglass 9 Other (Specify below)
 2 PVC 4 ABS 6 Asbestos-Cement 8 Concrete Tile
 Blank casing diameter 7.375 in. Was casing pulled? Yes No If yes, how much ~ 42'
 Casing height above or below land surface UNKNOWN in. OVERDRILLED TO 73'

6 GROUT PLUG MATERIAL: 1 Neat cement 2 Cement grout 3 Bentonite 4 Other 50165
 Grout Plug Intervals: From 34 ft. to 3 ft., From 3 ft. to 0 ft., From to ft.
 What is the nearest source of possible contamination:
 1 Septic tank 6 Seepage pit 17 Fuel storage 16 Other (specify below)
 2 Sewer lines 7 Pit privy 12 Fertilizer storage
 3 Watertight sewer lines 8 Sewage lagoon 13 Insecticide storage
 4 Lateral lines 9 Feedyard 14 Abandoned water well
 5 Cess Pool 10 Livestock pens 15 Oil well/Gas well
 Direction from well? SOUTHWEST How many feet? 375'

FROM	TO	PLUGGING MATERIALS
0	3	COMPACTED SOILS
3	34	BENTONITE CHIPS

7 CONTRACTOR'S OR LANDOWNER'S CERTIFICATION: This water well was plugged under my jurisdiction and was completed on (mo/day/year) 5/30/06 and this record is true to the best of my knowledge and belief. Kansas Water Well Contractor's License No. WIC/06 This Water Well Record was completed on (mo/day/year) 5/30/06 under the business name of QUAL STATE SERVICES, INC. by (signature) [Signature]

INSTRUCTIONS: Use typewriter or ball point pen. Please press firmly and print clearly. Please fill in blanks, underline or circle the correct answers. Send top three copies to Kansas Department of Health and Environment, Bureau of Water, Topeka, Kansas 66620-0001. Telephone: 785/296-3565. Send one to Water Well Owner and retain one for your records.