


1	LOCATION OF WATER WELL: County: <u>Ness</u>	Fraction <u>SE 1/4 NE 1/4 SW 1/4</u>	Section Number <u>30</u>	Township Number <u>17</u>	Range Number <u>73W</u>
---	--	---	-----------------------------	------------------------------	----------------------------

Distance and direction from nearest town or city street address of well if located within city?  
NEAR SOUTHWEST CORNER CHESTNUT AND COURT ST.

2	WATER WELL OWNER: <u>HAROLD WABLE</u> RR #, St. Address, Box #: <u>301 W. SYCAMORE</u> City, State, ZIP Code: <u>NESS CITY, KS. 67560</u>	Board of Agriculture, Division of Water Resources Application Number: <u>40</u>
---	---	--

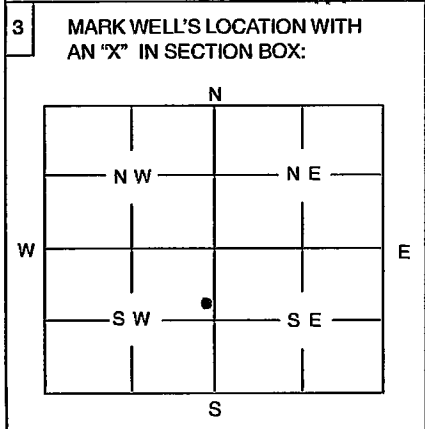

4 DEPTH OF WELL ..... 40 ..... ft

WELL'S STATIC WATER LEVEL 33.03 ft.

WELL WAS USED AS:

1 Domestic	5 Public Water Supply	9 Dewatering
2 Irrigation	6 Oil Field Water Supply	10 Monitoring Well
3 Feedlot	7 Domestic (Lawn & Garden)	11 Injection Well
4 Industrial	8 Air Conditioning	12 Other .....

Was a chemical / bacteriological sample submitted to Department? Yes ..... No

If yes, mo/day/yr sample was submitted N/A

Water Well Disinfected: Yes ..... No

5 TYPE OF BLANK CASING USED:

1 Steel	3 RMP (SR)	5 Wrought	7 Fiberglass	9 Other (Specify below)
2 PVC	4 ABS	6 Asbestos-Cement	8 Concrete Tile	

Blank casing diameter 7.375 in. Was casing pulled? Yes  No ..... If yes, how much 40'

Casing height above or below land surface UNKNOWN in. OVERBELLIED TO 73'

6 GROUT PLUG MATERIAL: 1 Neat cement 2 Cement grout 3 Bentonite 4 Other SOILS

Grout Plug Intervals: From 40 ft. to 3 ft., From 3 ft. to 0 ft., From ..... to ..... ft.

What is the nearest source of possible contamination:

1 Septic tank	6 Seepage pit	10 Fuel storage	16 Other (specify below)
2 Sewer lines	7 Pit privy	11 Fertilizer storage	
3 Watertight sewer lines	8 Sewage lagoon	12 Insecticide storage	
4 Lateral lines	9 Feedyard	13 Abandoned water well	
5 Cess Pool	10 Livestock pens	14 Oil well/Gas well	

Direction from well? SOUTH How many feet? 135'

FROM	TO	PLUGGING MATERIALS
<u>0</u>	<u>3</u>	<u>COMPACTED SOILS</u>
<u>3</u>	<u>40</u>	<u>BENTONITE CHIPS</u>

7 CONTRACTOR'S OR LANDOWNER'S CERTIFICATION: This water well was plugged under my jurisdiction and was completed on (mo/day/year) 5/12/02 and this record is true to the best of my knowledge and belief. 

INSTRUCTIONS: Use typewriter or ball point pen. Please press firmly and print clearly. Please fill in blanks, underline or circle the correct answers. Send top three copies to Kansas Department of Health and Environment, Bureau of Water, Topeka, Kansas 66620-0001. Telephone: 785/296-3565. Send one to Water Well Owner and retain one for your records.