


1 LOCATION OF WATER WELL: Fraction SE 1/4 NW 1/4 NE 1/4 Section Number 31 Township Number T 17 S Range Number R 73 E(N)
 County: NESS

Distance and direction from nearest town or city street address of well if located within city?
520 S. PENNSYLVANIA, NESS CITY, KANSAS

2 WATER WELL OWNER: HAROLD GABLE
 RR#, St. Address, Box #: 301 W. SYCAMORE, NESS CITY, KS 67500
 City, State, ZIP Code: 301 W. SYCAMORE, NESS CITY, KS 67500
 Board of Agriculture, Division of Water Resources
 Application Number:

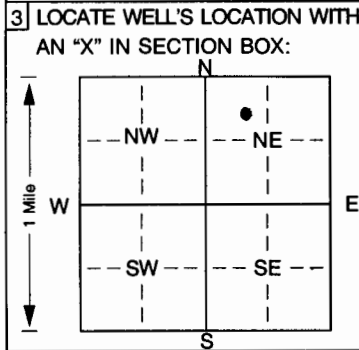

4 DEPTH OF COMPLETED WELL: 45 ft. ELEVATION: 5/27/02
 Depth(s) Groundwater Encountered: 33 ft.
 WELL'S STATIC WATER LEVEL: 33.31 ft. below land surface measured on mo/day/yr
 Pump test data: Well water was _____ ft. after _____ hours pumping _____ gpm
 Est. Yield _____ gpm: Well water was _____ ft. after _____ hours pumping _____ gpm
 Bore Hole Diameter: 1 1/2 in. to 4 1/2 in. and _____ in. to _____ in.
 WELL WATER TO BE USED AS: 5 Public water supply 8 Air conditioning 11 Injection well
 1 Domestic 3 Feedlot 6 Oil field water supply 9 Dewatering
 2 Irrigation 4 Industrial 7 Domestic (lawn & garden) 10 Monitoring well
 (13) AIR SPACE WELL
 Was a chemical/bacteriological sample submitted to Department? Yes. _____ No. ; If yes, mo/day/yr sample was submitted
 Water Well Disinfected? Yes _____ No

5 TYPE OF BLANK CASING USED:
 1 Steel 3 RMP (SR) 5 Wrought iron 8 Concrete tile CASING JOINTS: Glued. _____ Clamped. _____
 2 PVC 4 ABS 6 Asbestos-Cement 9 Other (specify below) Welded
 7 Fiberglass _____ Threaded
 Blank casing diameter: 2.375 in. to 4.75 in. Dia _____ in. to _____ in. Dia _____ in. to _____ in. Dia
 Casing height above land surface: FLUSH MOUNT in., weight _____ lbs./ft. Wall thickness or gauge No. 50H 40
 TYPE OF SCREEN OR PERFORATION MATERIAL:
 1 Steel 3 Stainless steel 5 Fiberglass 7 PVC 10 Asbestos-cement
 2 Brass 4 Galvanized steel 6 Concrete tile 8 RMP (SR) 11 Other (specify) _____
 9 ABS 12 None used (open hole)
 SCREEN OR PERFORATION OPENINGS ARE:
 1 Continuous slot 3 Mill slot 5 Gauzed wrapped 8 Saw cut 11 None (open hole)
 2 Louvered shutter 4 Key punched 6 Wire wrapped 9 Drilled holes
 7 Torch cut 10 Other (specify) _____
 SCREEN-PERFORATED INTERVALS: From 45 ft. to 42.5 ft. From _____ ft. to _____ ft.
 From _____ ft. to _____ ft. From _____ ft. to _____ ft.
 GRAVEL PACK INTERVALS: From 45 ft. to 41 ft. From _____ ft. to _____ ft.
 From _____ ft. to _____ ft. From _____ ft. to _____ ft.

6 GROUT MATERIAL: 1 Neat cement 3 Cement grout 4 Bentonite 4 Other _____
 Grout Intervals: From _____ ft. to _____ ft. From _____ ft. to _____ ft. From _____ ft. to _____ ft.
 What is the nearest source of possible contamination:
 1 Septic tank 4 Lateral lines 7 Pit privy 10 Livestock pens 14 Abandoned water well
 2 Sewer lines 5 Cess pool 8 Sewage lagoon 11 Fuel storage (FORMER) 15 Oil well/Gas well
 3 Watertight sewer lines 6 Seepage pit 9 Feedyard 12 Fertilizer storage 16 Other (specify below)
 13 Insecticide storage _____
 Direction from well? NORTHWEST How many feet? 60

FROM	TO	LITHOLOGIC LOG	FROM	TO	PLUGGING INTERVALS
0	17.5	DARK BN CLAY, FIRM - V FIRM DRY			
17.5	25	BN CLAY, SOME FINE - COARSE GRAINED SANDS, V FIRM, DRY			
25	27.5	BN CLAY, CALICHE NODULES AND SPRINGERS, SOME FINE - COARSE GRAINED SANDS, V FIRM, DRY			
27.5	40	GRAY CLAYEN SANDS - SANDS GRAVELLY, FINE - COARSE GRAINED, WET @ 33', MODERATE - STRONG ODOUR			
40	45	GRAY FINE - COARSE GRAINED SANDS, GRAVELLY, WET, MODERATE ODOUR			
FLUSH MOUNT COMPLETION APPROVED BY <u>BOB TAYLOR, KCHE-BOW</u>					

7 CONTRACTOR'S OR LANDOWNER'S CERTIFICATION: This water well was (1) constructed, (2) reconstructed, or (3) plugged under my jurisdiction and was completed on (mo/day/year) 5/23/02 and this record is true to the best of my knowledge and belief. Kansas Water Well Contractor's Licence No. 642 This Water Well Record was completed on (mo/day/yr) 5/23/02 under the business name of QUAD STATE SERVICES, INC. by (signature) [Signature]