


1 LOCATION OF WATER WELL: Fraction SE 1/4 NW 1/4 NE 1/4 Section Number 31 Township Number 18 Range Number 23W  
 County: NESS

Distance and direction from nearest town or city street address of well if located within city?  
520 S. PENNSYLVANIA, NESS CITY, KANSAS

2 WATER WELL OWNER: HAROLD VABLE  
 RR #, St. Address, Box #: 301 W. GYEMORE  
 City, State, ZIP Code: NESS CITY, KS. 67620  
 Board of Agriculture, Division of Water Resources  
 Application Number:

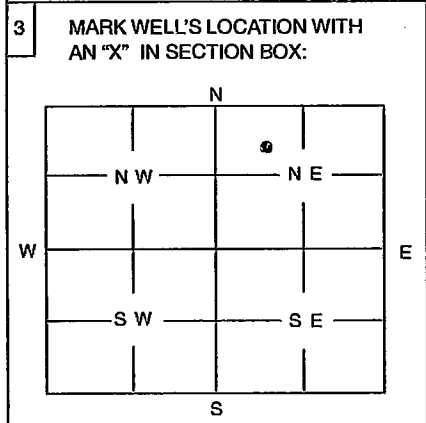

4 DEPTH OF WELL 42 ft  
 WELL'S STATIC WATER LEVEL 36.60 ft  
 WELL WAS USED AS:  
 1 Domestic 2 Irrigation 3 Feedlot 4 Industrial 5 Public Water Supply 6 Oil Field Water Supply 7 Domestic (Lawn & Garden) 8 Air Conditioning 9 Dewatering 10 Monitoring Well 11 Injection Well 12 Other  
 Was a chemical / bacteriological sample submitted to Department? Yes  No   
 If yes, mo/day/yr sample was submitted N/A  
 Water Well Disinfected: Yes  No

5 TYPE OF BLANK CASING USED:  
 1 Steel 2 PVC 3 RMP (SR) 4 ABS 5 Wrought 6 Asbestos-Cement 7 Fiberglass 8 Concrete Tile 9 Other (Specify below)  
 Blank casing diameter 2.315 in. Was casing pulled? Yes  No  If yes, how much 42  
 Casing height above or below land surface 1.55 in. OVERDRILLED TO 23'

6 GROUT PLUG MATERIAL: 1 Neat cement 2 Cement grout 3 Bentonite 4 Other SOILS  
 Grout Plug Intervals: From 42 ft. to 3 ft., From 3 ft. to 0 ft., From ..... to ..... ft.  
 What is the nearest source of possible contamination:  
 1 Septic tank 2 Sewer lines 3 Watertight sewer lines 4 Lateral lines 5 Cess Pool 6 Seepage pit 7 Pit privy 8 Sewage lagoon 9 Feedyard 10 Livestock pens 11 Fuel storage (FURNACE) 12 Fertilizer storage 13 Insecticide storage 14 Abandoned water well 15 Oil well/Gas well 16 Other (specify below)  
 Direction from well? EAST/NORTH How many feet? 150

FROM	TO	PLUGGING MATERIALS
0	3	COMPACTED SOILS
3	42	BENTONITE CHIPS

7 CONTRACTOR'S OR LANDOWNER'S CERTIFICATION: This water well was plugged under my jurisdiction and was completed on (mo/day/year) 2/16/06 and this record is true to the best of my knowledge and belief. Kansas Water Well Contractor's License No. 2166106 under the business name of QUAD STATE SERVICES, INC. This Water Well Record was completed on (mo/day/year) 2/16/06 by (signature) [Signature]

INSTRUCTIONS: Use typewriter or ball point pen. Please press firmly and print clearly. Please fill in blanks, underline or circle the correct answers. Send top three copies to Kansas Department of Health and Environment, Bureau of Water, Topeka, Kansas 66620-0001. Telephone: 785/296-3565. Send one to Water Well Owner and retain one for your records.