


MW-a 9

1 LOCATION OF WATER WELL: Fraction SE 1/4 NW 1/4 NE 1/4 Section Number 31 Township Number T 18 S Range Number R 3 E/W
 County: NESS

Distance and direction from nearest town or city street address of well if located within city?
570 S. PENNSYLVANIA NESS CITY, KANSAS

2 WATER WELL OWNER: HAROLD GABLE
 RR#, St. Address, Box # : 301 W. SYCAMORE, NESS CITY, KS. 66260
 City, State, ZIP Code :
 Board of Agriculture, Division of Water Resources
 Application Number:

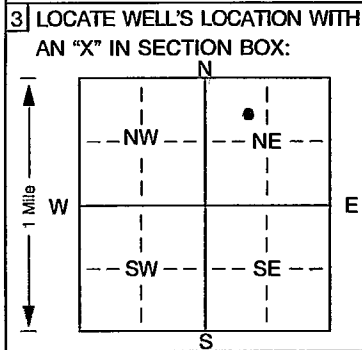

4 DEPTH OF COMPLETED WELL: 40 ft. ELEVATION: 32 ft.
 Depth(s) Groundwater Encountered: 32 ft. 2. 32 ft. 3. 32 ft.
 WELL'S STATIC WATER LEVEL: 32 ft. below land surface measured on mo/day/yr 5/21/02
 Pump test data: Well water was _____ ft. after _____ hours pumping _____ gpm
 Est. Yield _____ gpm Well water was _____ ft. after _____ hours pumping _____ gpm
 Bore Hole Diameter: 8 1/2 in. to 40 ft., and _____ in. to _____ ft.
 WELL WATER TO BE USED AS:
 5 Public water supply 8 Air conditioning 11 Injection well
 1 Domestic 3 Feedlot 6 Oil field water supply 9 Dewatering 12 Other (Specify below)
 2 Irrigation 4 Industrial 7 Domestic (lawn & garden) 10 Monitoring well
 Was a chemical/bacteriological sample submitted to Department? Yes _____ No ✓; If yes, mo/day/yrs sample was submitted _____
 Water Well Disinfected? Yes _____ No ✓

5 TYPE OF BLANK CASING USED:
 1 Steel 3 RMP (SR) 5 Wrought iron 8 Concrete tile CASING JOINTS: Glued _____ Clamped _____
2 PVC 4 ABS 6 Asbestos-Cement 9 Other (specify below) Welded _____
 7 Fiberglass Threaded ✓
 Blank casing diameter: 7.375 in. to 7.5 ft., Dia _____ in. to _____ ft., Dia _____ in. to _____ ft.
 Casing height above land surface: FLUSH MOUNT in., weight _____ lbs./ft. Wall thickness or gauge No. 50 40
 TYPE OF SCREEN OR PERFORATION MATERIAL:
 1 Steel 3 Stainless steel 5 Fiberglass 7 PVC 10 Asbestos-cement
 2 Brass 4 Galvanized steel 6 Concrete tile 8 RMP (SR) 11 Other (specify) _____
 9 ABS 12 None used (open hole)
 SCREEN OR PERFORATION OPENINGS ARE:
 1 Continuous slot 5 Gauzed wrapped 8 Saw cut 11 None (open hole)
3 Mill slot 6 Wire wrapped 9 Drilled holes
 2 Louvered shutter 4 Key punched 7 Torch cut 10 Other (specify) _____ ft.
 SCREEN-PERFORATED INTERVALS: From 40 ft. to 75 ft., From _____ ft. to _____ ft.
 From _____ ft. to _____ ft., From _____ ft. to _____ ft.
 GRAVEL PACK INTERVALS: From 40 ft. to 75 ft., From _____ ft. to _____ ft.
 From _____ ft. to _____ ft., From _____ ft. to _____ ft.

6 GROUT MATERIAL: 1 Neat cement 2 Cement grout 3 Bentonite 4 Other _____
 Grout Intervals: From 0 ft. to 3 ft., From 3 ft. to 75 ft., From _____ ft. to _____ ft.
 What is the nearest source of possible contamination:
 1 Septic tank 4 Lateral lines 7 Pit privy 10 Livestock pens 14 Abandoned water well
 2 Sewer lines 5 Cess pool 8 Sewage lagoon 11 Fuel storage (FURNACE) 15 Oil well/Gas well
 3 Watertight sewer lines 6 Seepage pit 9 Feedyard 12 Fertilizer storage 16 Other (specify below)
 13 Insecticide storage
 Direction from well? WEST / N.WEST How many feet? 110

| FROM | TO | LITHOLOGIC LOG | FROM | TO | PLUGGING INTERVALS |
|---|----|--|------|----|--------------------|
| 0 | 75 | BROWN SILTY CLAY, FIRM, DRY TRACE CALICHE | | | |
| 75 | 31 | BROWN SILTY CLAY, FIRM, DRY TO SL MOIST TRACE SANDS | | | |
| 31 | 33 | BAU - LT BU CLAYEN SANDS, WET @ 32' | | | |
| 33 | 40 | GRAY SANDS FINE TO COARSE GRAINED, WELL GRADED, WET, FAINT ODDER | | | |
| FLUSH MOUNT COMPLETION APPROVED BY DON TAYLOR, KANSAS-BOW | | | | | |

7 CONTRACTOR'S OR LANDOWNER'S CERTIFICATION: This water well was (1) constructed, (2) reconstructed, or (3) plugged under my jurisdiction and was completed on (mo/day/year) 5/21/02 and this record is true to the best of my knowledge and belief. Kansas Water Well Contractor's Licence No. 642 This Water Well Record was completed on (mo/day/yr) 5/21/02 under the business name of QUAD STATE SERVICES, INC. by (signature) [Signature]