


1 LOCATION OF WATER WELL: Fraction SE 1/4 NW 1/4 NE 1/4 Section Number 31 Township Number T 18 S Range Number R 73 E/W
 County: NESS

Distance and direction from nearest town or city street address of well if located within city?
520 S. PENNSYLVANIA, NESS CITY, KANSAS

2 WATER WELL OWNER: HAROLD GABLE
 RR#, St. Address, Box #: 301 W. SYCAMORE, NESS CITY, KS. 67560
 City, State, ZIP Code: NESS CITY, KS. 67560
 Board of Agriculture, Division of Water Resources
 Application Number:

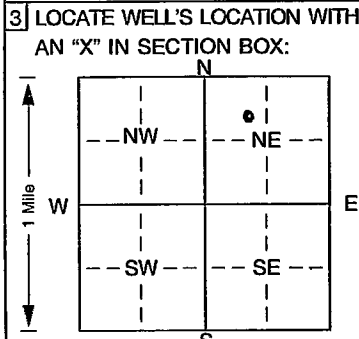

4 DEPTH OF COMPLETED WELL: 35 ft. ELEVATION: ft.
 Depth(s) Groundwater Encountered: ft. 2. ft. 3. ft.
 WELL'S STATIC WATER LEVEL: ca. 40 ft. below land surface measured on mo/day/yr 5/21/02
 Pump test data: Well water was ft. after hours pumping gpm
 Est. Yield gpm: Well water was ft. after hours pumping gpm
 Bore Hole Diameter: 8 1/2 in. to 35 ft., and in. to ft.
 WELL WATER TO BE USED AS: 5 Public water supply 8 Air conditioning 11 Injection well
 1 Domestic 3 Feedlot 6 Oil field water supply 9 Dewatering 12 Other (Specify below)
 2 Irrigation 4 Industrial 7 Domestic (lawn & garden) 10 Monitoring well
 Was a chemical/bacteriological sample submitted to Department? Yes. No. ; If yes, mo/day/yr sample was submitted
 Water Well Disinfected? Yes No

5 TYPE OF BLANK CASING USED: 5 Wrought iron 8 Concrete tile CASING JOINTS: Glued. Clamped.
 1 Steel 3 RMP (SR) 6 Asbestos-Cement 9 Other (specify below) Welded
2 PVC 4 ABS 7 Fiberglass Threaded.
 Blank casing diameter: 7.375 in. to 20 ft., Dia in. to ft., Dia in. to ft.
 Casing height above land surface: FLUSH MOUNT in., weight lbs./ft. Wall thickness or gauge No. 50M 40
 TYPE OF SCREEN OR PERFORATION MATERIAL: 2 PVC 10 Asbestos-cement
 1 Steel 3 Stainless steel 5 Fiberglass 8 RMP (SR) 11 Other (specify)
 2 Brass 4 Galvanized steel 6 Concrete tile 9 ABS 12 None used (open hole)
 SCREEN OR PERFORATION OPENINGS ARE: 5 Gauzed wrapped 8 Saw cut 11 None (open hole)
 1 Continuous slot 3 Mill slot 6 Wire wrapped 9 Drilled holes
 2 Louvered shutter 4 Key punched 7 Torch cut 10 Other (specify) ft.
 SCREEN-PERFORATED INTERVALS: From 35 ft. to 20 ft., From ft. to ft.
 From ft. to ft., From ft. to ft.
 GRAVEL PACK INTERVALS: From 35 ft. to 18 ft., From ft. to ft.
 From ft. to ft., From ft. to ft.

6 GROUT MATERIAL: 1 Neat cement 3 2 Cement grout 1 Bentonite 4 Other
 Grout Intervals: From 0 ft. to 3 ft., From 18 ft. to 3 ft., From ft. to ft.
 What is the nearest source of possible contamination:
 1 Septic tank 4 Lateral lines 7 Pit privy 10 Livestock pens 14 Abandoned water well
 2 Sewer lines 5 Cess pool 8 Sewage lagoon 11 Fuel storage (FORMER) 15 Oil well/Gas well
 3 Watertight sewer lines 6 Seepage pit 9 Feedyard 12 Fertilizer storage 16 Other (specify below)
 13 Insecticide storage
 Direction from well? NORTHWEST How many feet? 75

| FROM | TO | LITHOLOGIC LOG | FROM | TO | PLUGGING INTERVALS |
|--|----|--|------|----|--------------------|
| 0 | 20 | BN SILTY CLAY - CLAY, FIRM, MOIST | | | |
| 20 | 24 | BN SANDY CLAY, FINE TO COARSE GRAINED SANDS, FIRM, MOIST, WET @ 24 | | | |
| 24 | 35 | TAN - (L) BN SILTY SANDS - SANDS FINE TO COARSE GRAINED, WELL GRAINED, WET | | | |
| FLUSH MOUNT COMPLETION APPROVED BY <u>BOW TAYLOR, KONE-BOW</u> | | | | | |

7 CONTRACTOR'S OR LANDOWNER'S CERTIFICATION: This water well was (1) constructed, (2) reconstructed, or (3) plugged under my jurisdiction and was completed on (mo/day/year) 5/21/02 and this record is true to the best of my knowledge and belief. Kansas Water Well Contractor's Licence No. 642 This Water Well Record was completed on (mo/day/yr) 5/21/02 under the business name of QUAN STATE SERVICES, INC. by (signature) [Signature]