


1 LOCATION OF WATER WELL: Fraction Section Number Township Number Range Number
 COUNTY: NESS NW 1/4 1/4 1/4 30 T 18 S R 23 W

Distance and direction from nearest town or city street address of well if located within city?

702 JAMES NESS CITY, KS 67560-

2 WATER WELL OWNER: MELLIES, DAVE
 RR#, St. Address, Box #: 702 JAMES Board of Agriculture, Division of Water Resources
 City, State, ZIP code : NESS CITY, KS 67560- Application Number:

3 LOCATE WELL'S LOCATION WITH AN "X" IN SECTION BOX:

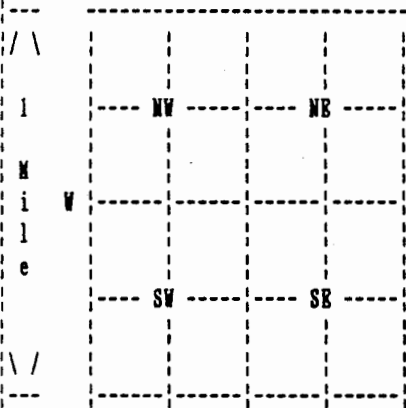

4 DEPTH OF COMPLETED WELL 286 ELEVATION: 0
 Depth(s) Groundwater Encountered 1. 0 ft. 2. 0 ft. 3. 0 ft.

WELL'S STATIC WATER LEVEL 135 ft. below land surface measured on mo/day/yr 03/27/06
 Pump testdata: Well water was 0 ft. after 0 hours pumping 0 gpm

Estimated Yield 35 gpm: Well water was 0 ft. after 0 hours pumping 0 gpm

Bore Hole Diameter 9 in. to 286 ft., and in. to 0 ft.

WELL WATER TO BE USED AS: LAWN & GARDEN

Was a chemical/bacteriological sample submitted to department? No ;
 If yes, mo/day/yr sample was submitted Water well disinfected? Yes

5 TYPE OF BLANK CASING USED: CERTA LOC CASIN CASING JOINTS: CERTA-LOC
 Blank casing diameter 5 in. to 286 ft., Dia in. to 0 ft., Dia in. to 0 ft.
 Casing height above land surface 12 in., weight 200 lbs/ft. Wall thickness or gauge No. 21
 TYPE OF SCREEN OR PERFORATION MATERIAL: PVC
 SCREEN OR PERFORATION OPENINGS ARE: SAW CUT

SCREEN PERFORATED INTERVALS: From 200 ft. to 280 ft., From 0 ft. to 0 ft.
 From 0 ft. to 0 ft., From 0 ft. to 0 ft.
 GRAVEL PACK INTERVALS: From 26 ft. to 286 ft., From 0 ft. to 0 ft.
 From 0 ft. to 0 ft., From 0 ft. to 0 ft.

6 GROUT MATERIAL BENTONITE
 Grout Intervals: From 5 ft. to 26 ft., From 0 ft. to 0 ft., From 0 ft. to 0 ft.
 What is the nearest source of possible contamination: NONE
 Direction from well? How many feet? 0

| FROM | TO | LITHOLOGIC LOG | FROM | TO | PLUGGING INTERVALS |
|------|-----|--------------------------------------|------|----|--------------------|
| 0 | 20 | 01 TOPSOIL 32 TAN CLAY | | | |
| 20 | 40 | 32 TAN CLAY 36 BLUE CLAY | | | |
| 40 | 100 | 07 BLUE SHALE | | | |
| 100 | 120 | 29 SANDSTONE | | | |
| 120 | 140 | 07 BLUE SHALE | | | |
| 140 | 180 | 07 BLUE SHALE 29 SANDSTONE 19 LAYERS | | | |
| 180 | 200 | 29 SANDSTONE | | | |
| 200 | 260 | 29 SANDSTONE 07 BLUE SHALE 19 LAYERS | | | |
| 260 | 286 | 29 SANDSTONE | | | |

7 CONTRACTOR'S OR LANDOWNER'S CERTIFICATION: This water well was Constructed under my jurisdiction and was completed on (mo/day/year) 02/28/06 and this record is true to the best of my knowledge and belief. Kansas Water Well Contractor's License No. 179 This Water Well Record was completed on (mo/day/yr) 03/30/06 under the business name of JOB'S WELL SERVICE, INC. by (signature) *Justin Creek*