

CORRECTION(S) TO WATER WELL RECORD (WWC-5)

(to rectify lacking or incorrect information)

County: Trego

Location listed as:

Section-Township-Range: 32-18 S-23 W

Fraction ($\frac{1}{4}$ $\frac{1}{4}$ $\frac{1}{4}$): NE SE NE

Location changed to:

32-14 S-23 W

C SE NE

Other changes: Initial statements: _____

Changed to: _____

Comments: _____

verification method: Phone call to Linda Crossland, Wakeeney, and mapping tool on KGS website.

initials: BR date: 5/1/2007

MAR 10 2007

WATER WELL PLUGGING RECORD Form WWC-5P

KSA 82a-1212 ID NO.


1 LOCATION OF WATER WELL: County: Trego Fraction NE 1/4 SE 1/4 NE 1/4 Section Number 32 Township Number 18 S Range Number 23 EW

Distance and direction from nearest town or city street address of well if located within city?

2 WATER WELL OWNER: Family Farm LLC c/o Linda Crossland RR#, St. Address, Box #: PO Box 836 City, State ZIP Code: Wakeeney, KS 67530

Global Positioning Systems (decimal degrees, min. of 4 digits) Latitude: Longitude: Elevation: Datum: Data Collection Method:

3 MARK WELL'S LOCATION WITH AN "X" IN SECTION BOX:

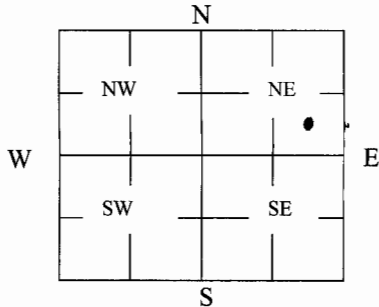

4 DEPTH OF WELL 40 ft.

WELL'S STATIC WATER LEVEL 2 ft

WELL WAS USED AS:

- 1 Domestic 2 Irrigation 3 Feedlot 4 Industrial 5 Public Water Supply 6 Oil Field Water Supply 7 Domestic (Lawn & Garden) 8 Air Conditioning 9 Dewatering 10 Monitoring 11 Injection Well 12 Other Not Used

Was a chemical/bacteriological sample submitted to Department? Yes No X

5 TYPE OF BLANK CASING USED:

- 1 Steel 2 PVC 3 RMP (SR) 4 ABS 5 Wrought 6 Asbestos-Cement 7 Fiberglass 8 Concrete Tile 9 Other (Specify below)

Blank casing diameter 4 in. Was casing pulled? Yes No If yes, how much Casing height above or below land surface 48 in. below

6 GROUT PLUG MATERIAL: 1 Neat cement 2 Cement grout 3 Bentonite 4 Other

Grout Plug Intervals: From 20 ft. to 4 ft., From ft. to ft., From to ft.

What is the nearest source of possible contamination:

- 1 Septic tank 2 Sewer lines 3 Watertight sewer lines 4 Lateral lines 5 Cess pool 6 Seepage pit 7 Pit privy 8 Sewage lagoon 9 Feedyard 10 Livestock pens 11 Fuel Storage 12 Fertilizer storage 13 Insecticide storage 14 Abandoned water well 15 Oil well/Gas well 16 Other (specify below) None

Table with 6 columns: FROM, TO, PLUGGING MATERIALS, FROM, TO, PLUGGING MATERIALS. Rows include: 40' to 20' Gravel; 20' to 4' Cement Grout; 4' to 0' Removed Casing.

7 CONTRACTOR'S OR LANDOWNER'S CERTIFICATION: This water well was plugged under my jurisdiction and was completed on (mo/day/year) and this record is true to the best of my knowledge and belief. Kansas Water Well Contractor's License No. This Water Well Record was completed on (mo/day/year) 3-16-07 under the business name of Venture Corporation by (signature) Jeff M Barner PE

INSTRUCTIONS: Use typewriter or ballpoint pen. Please press firmly and print clearly. Please fill in blanks, underline or circle the correct answers. Send top three copies to Kansas Department of Health and Environment, Bureau of Water, Geology Section, 1000 SW Jackson St., Ste. 420, Topeka, Kansas 66612-1367. Telephone: 785/296-5522. Send one to Water Well Owner and retain one for your records. Visit us at http://www.kdheks.gov/geo/waterwells.