


1	LOCATION OF WATER WELL: Fraction	Section Number	Township Number	Range Number
County:	<b>Ness</b> <b>SE 1/4 NW 1/4 NE 1/4</b>	<b>31</b>	<b>18</b>	<b>23-West</b>

Distance and direction from nearest town or city street address of well if located within city?

**520 S. Pennsylvania, Ness City, Kansas**

2	WATER WELL OWNER: <b>Harold Gable</b>	Board of Agriculture, Division of Water Resources
RR#, St. Address, Box #	<b>301 Sycamore</b>	Application Number:
City, State, ZIP Code	<b>Ness City, Kansas 67560</b>	

3 MARK WELL'S LOCATON WITH AN "X" IN SECTION BOX:

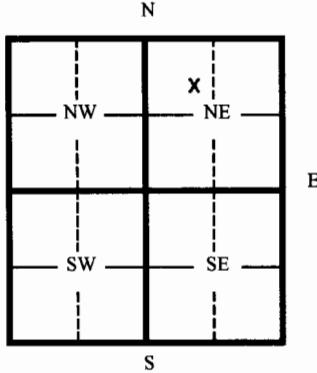

4	DEPTH OF WELL	<b>35</b>	ft.
	WELL'S STATIC WATER LEVEL	<b>30.99</b>	ft.
WELL WAS USED AS:			
1 Domestic	5 Public Water Supply	9 Dewatering	
2 Irrigation	6 Oil Field Water Supply	10 Monitoring Well	
3 Feedlot	7 Lawn and Garden (domestic)	11 Injection Well	
4 Industrial	8 Air Conditioning	<input checked="" type="radio"/> Other <u>Vapor Extraction Well</u>	
Was a chemical/bacteriological sample submitted to Department?		Yes	No <input checked="" type="checkbox"/>
If yes, mo/day/yr sample was submitted _____			
Water Well Disinfected:		Yes	No <input checked="" type="checkbox"/>

5	TYPE OF BLANK CASING USED:			
1 Steel	3 RMP (SR)	5 Wrought	7 Fiberglass	9 Other (specify below)
<input checked="" type="radio"/> PVC	4 ABC	6 Asbestos-Cement	8 Concrete Tile	
Blank casing diameter <b>2.375</b> in.		Was casing pulled? Yes _____ No <input checked="" type="checkbox"/>		If yes, how much? <b>N/A</b>
Casing height above or below land surface <b>Unknown</b> in.		<b>Casing plugged; casing removed to depth of 3' BTOC.</b>		

6	GROUT PLUG MATERIAL: 1 Neat cement 2 Cement grout <input checked="" type="radio"/> 3 Bentonite <input checked="" type="radio"/> 4 Other <b>Soils/Concrete</b>			
Grout Plug Intervals From <b>35.0</b> ft. to <b>3.0</b> ft. From <b>3.0</b> ft. to <b>1.0</b> ft. From <b>1.0</b> ft. to <b>0.0</b> ft.				

What is the nearest source of possible contamination:

- |                          |                   |   |                          |
|--------------------------|-------------------|---|--------------------------|
| 1 Septic tank            | 6 Seepage pit     | <input checked="" type="radio"/> 11 Fuel storage (former) | 16 Other (specify below) |
| 2 Sewer lines            | 7 Pit privy       | 12 Fertilizer storage                                     |                          |
| 3 Watertight sewer lines | 8 Sewage lagoon   | 13 Insecticide storage                                    |                          |
| 4 Lateral lines          | 9 Feedyard        | 14 Abandoned water well                                   |                          |
| 5 Cess Pool              | 10 Livestock pens | 15 Oil well/ Gas well                                     |                          |

Direction from well? **Northwest** How many feet? **70**

FROM	TO	CODE	PLUGGING MATERIALS
<b>0.0</b>	<b>1.0</b>		<b>Concrete</b>
<b>1.0</b>	<b>3.0</b>		<b>Soils</b>
<b>3.0</b>	<b>35.0</b>		<b>Bentonite chips</b>

7	CONTRACTOR'S OR LANDOWNER'S CERTIFICATION: This water well was plugged under my jurisdiction and was completed on (mo/day/yr) <b>05/24/07</b> and this record is true to the best of my knowledge and belief. Kansas Water Well Contractor's License No. <b>692</b> This Water Well Record was completed on (mo/day/yr) <b>05/25/07</b> under the business name of <b>Quad State Services, Inc.</b> by (signature) <i>[Signature]</i>	
---	---	--

INSTRUCTIONS: Please fill in blanks and circle the correct answers. Send three copies to Kansas Department of Health and Environment, Bureau of Water, 1000 S W Jackson St., Ste. 420, Topeka, Kansas 66620-0001. Telephone: 785-296-3565. Send one to Water Well Owner and retain one for your records.