

CORRECTION(S) TO WATER WELL RECORD (WWC-5)
(to rectify lacking or incorrect information)

County: Ness

Location listed as:

Section-Township-Range: 30-185-23W

Fraction (1/4 1/4 1/4): None Given

Location changed to:

30-185-23W

E2 NW SW

Other changes: Initial statements: _____

Changed to: _____

Comments: _____

verification method: Wellsite address, city street map, and mapping tool & aerial photos on KGS website.

initials: DR date: 2/9/2009

submitted by: Kansas Geological Survey, Data Resources Library, 1930 Constant Ave., Lawrence, KS 66047-3726
to: Kansas Dept of Health & Environment, Bureau of Water, 1000 SW Jackson, Suite 420, Topeka, KS 66612-1367.


CORRECTED COPY

1 LOCATION OF WATER WELL: Fraction 1/4 1/4 1/4 Section Number 30 Township Number T 18 S Range Number R 23 W
 COUNTY: NESS

Distance and direction from nearest town or city street address of well if located within city?
 NESS CITY, KS 67560- 302 N High Street

2 WATER WELL OWNER: VOGEL, BLAINE
 RR#, St. Address, Box #: Box 327 Board of Agriculture, Division of Water Resources
 City, State, ZIP code: NESS CITY, KS 67560- Application Number:

3 LOCATE WELL'S LOCATION WITH AN "X" IN SECTION BOX:

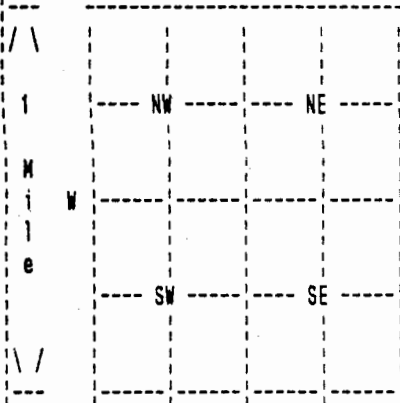

4 DEPTH OF COMPLETED WELL 60 ELEVATION: 0
 Depth(s) Groundwater Encountered 1. 0 ft. 2. 0 ft. 3. 0 ft.

WELL'S STATIC WATER LEVEL 30 ft. below land surface measured on mo/day/yr 11/12/08
 Pump test data: Well water was 0 ft. after 0 hours pumping 0 gpm

Estimated Yield 30 gpm: Well water was 0 ft. after 0 hours pumping 0 gpm

Bore Hole Diameter 10 in. to 60 ft., and in. to 0 ft.

WELL WATER TO BE USED AS: LAWN & GARDEN

Was a chemical/bacteriological sample submitted to department? No ;
 If yes, mo/day/yr sample was submitted Water well disinfected? Yes

5 TYPE OF BLANK CASING USED: CERTA LOC CASIN CASING JOINTS: CERTA-LOC
 Blank casing diameter 5 in. to 60 ft., Dia in. to 0 ft., Dia in. to 0 ft.
 Casing height above land surface 12 in., weight 200 lbs/ft. Wall thickness or gauge No. 21
 TYPE OF SCREEN OR PERFORATION MATERIAL: PVC
 SCREEN OR PERFORATION OPENINGS ARE: SAW CUT

SCREEN PERFORATED INTERVALS: From 20 ft. to 40 ft., From 0 ft. to 0 ft.
 From 0 ft. to 0 ft., From 0 ft. to 0 ft.
 GRAVEL PACK INTERVALS: From 20 ft. to 60 ft., From 0 ft. to 0 ft.
 From 0 ft. to 0 ft., From 0 ft. to 0 ft.

6 GROUT MATERIAL BENTONITE
 Grout Intervals: From 0 ft. to 20 ft., From 0 ft. to 0 ft., From 0 ft. to 0 ft.
 What is the nearest source of possible contamination: NONE
 Direction from well? How many feet? 0

FROM	TO	LITHOLOGIC LOG	FROM	TO	PLUGGING INTERVALS
0	20	01 TOPSOIL 32 TAN CLAY			
20	40	32 TAN CLAY 37 FIN-COAR SAN 06 SMALL GRAVEL			
40	60	07 BLUE SHALE			

7 CONTRACTOR'S OR LANDOWNER'S CERTIFICATION: This water well was Constructed under my jurisdiction and was completed on (mo/day/year) 11/12/08 and this record is true to the best of my knowledge and belief. Kansas Water Well Contractor's License No. 179 This Water Well Record was completed on (mo/day/yr) 12/11/08 under the business name of JOE'S WELL SERVICE, INC. by (signature) Judith Curt