


1 LOCATION OF WATER WELL:	Fraction	Section Number	Township Number	Range Number
County: Ness	SE 1/4 SE 1/4 NW 1/4	30	T 18 S	R 23 EW

Distance and direction from nearest town or city street address of well if located within city?
 Within the city limits of Ness City - On east side of Franklin between Prospect & North St.

2 WATER WELL OWNER: Ness City, City of
 RR#, St. Address, Box #: 109 S. Iowa Box 419
 City, State, ZIP Code: Ness City, KS 67560
 Board of Agriculture, Division of Water Resources
 Application Number: VR NS003

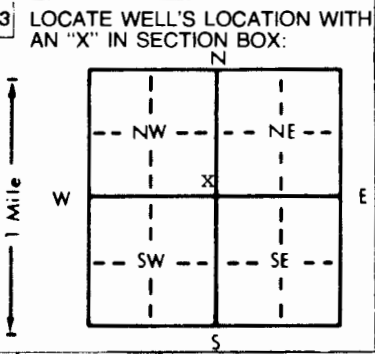

4 DEPTH OF COMPLETED WELL: 37 ft. ELEVATION:
 Depth(s) Groundwater Encountered 1. ft. 2. ft. 3. ft.
 WELL'S STATIC WATER LEVEL: 22.1 ft. below land surface measured on mo/day/yr 4-18-94
 Pump test data: Well water was ft. after hours pumping gpm
 Est. Yield gpm: Well water was ft. after hours pumping gpm
 Bore Hole Diameter in. to ft. and in. to ft.
 WELL WATER TO BE USED AS:
 5 Public water supply 8 Air conditioning 11 Injection well
 1 Domestic was 3 Feedlot 6 Oil field water supply 9 Dewatering 12 Other (Specify below)
 2 Irrigation 4 Industrial 7 Lawn and garden only 10 Monitoring well
 Was a chemical/bacteriological sample submitted to Department? Yes No; If yes, mo/day/yr sample was submitted
 Water Well Disinfected? Yes No

5 TYPE OF BLANK CASING USED:
 1 Steel 3 RMP (SR) 5 Wrought iron 8 Concrete tile CASING JOINTS: Glued Clamped
 2 PVC 4 ABS 6 Asbestos-Cement 9 Other (specify below) Welded
 7 Fiberglass Threaded
 Blank casing diameter 12" in. to ft. Dia. in. to ft. Dia. in. to ft.
 Casing height above land surface 30" above ground level lbs./ft. Wall thickness or gauge No.
 TYPE OF SCREEN OR PERFORATION MATERIAL:
 1 Steel 3 Stainless steel 5 Fiberglass 7 PVC 10 Asbestos-cement
 2 Brass 4 Galvanized steel 6 Concrete tile 8 RMP (SR) 11 Other (specify)
 9 ABS 12 None used (open hole)
 SCREEN OR PERFORATION OPENINGS ARE:
 1 Continuous slot 5 Gauzed wrapped 8 Saw cut 11 None (open hole)
 2 Louvered shutter 4 Mill slot 6 Wire wrapped 9 Drilled holes
 7 Torch cut 10 Other (specify)
 SCREEN-PERFORATED INTERVALS: From ft. to ft. From ft. to ft.
 GRAVEL PACK INTERVALS: From ft. to ft. From ft. to ft.

6 GROUT MATERIAL: 1 Neat cement 2 Cement grout 3 Bentonite 4 Other
 Grout Intervals: From 22.1 ft. to 0 ft. From ft. to ft. From ft. to ft.
 What is the nearest source of possible contamination:
 1 Septic tank 4 Lateral lines 7 Pit privy 10 Livestock pens 14 Abandoned water well
 2 Sewer lines 5 Cess pool 8 Sewage lagoon 11 Fuel storage 15 Oil well/Gas well
 3 Watertight sewer lines 6 Seepage pit 9 Feedyard 12 Fertilizer storage 16 Other (specify below)
 13 Insecticide storage None known.

FROM	TO	LITHOLOGIC LOG	FROM	TO	PLUGGING INTERVALS
			37	22.1	Chlorinated sand
			22.1	0	Concrete grout
					Concrete grout to top of casing (30" above ground level)

7 CONTRACTOR'S OR LANDOWNER'S CERTIFICATION: This water well was (1) constructed, (2) reconstructed, or (3) plugged under my jurisdiction and was completed on (mo/day/year) 6-18-94 and this record is true to the best of my knowledge and belief. Kansas Water Well Contractor's License No. 185 This Water Well Record was completed on (mo/day/yr) 7-8-94 under the business name of Clarke Well & Equipment, Inc. by signature *Clarke Well & Equipment, Inc.*

OFFICE USE ONLY
T
R
EW
SEC.
1/4
1/4
1/4