


1 LOCATION OF WATER WELL: County: **NESS** Fraction: **NE 1/4 NE 1/4 SW 1/4** Section Number: **30** Township Number: **T 18 S** Range Number: **R 23 E/W**

Distance and direction from nearest town or city street address of well if located within city?
1/2 B-N OF GRANT ON JAMES

2 WATER WELL OWNER: **HOME DIL CO- HAROLD GABLE**
 RR#, St. Address, Box #: **301 W SYCAMORE NESS CITY KS 67560**
 City, State, ZIP Code: **NESS CITY KS 67560**
 Board of Agriculture, Division of Water Resources
 Application Number:

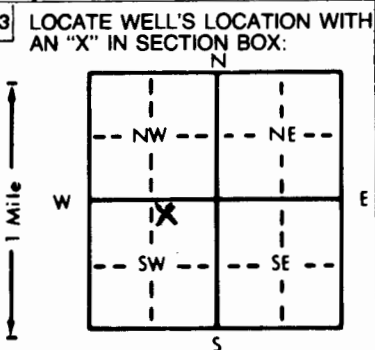

4 DEPTH OF COMPLETED WELL: **50** ft. ELEVATION:
 Depth(s) Groundwater Encountered 1. **34** ft. 2. — ft. 3. — ft.
 WELL'S STATIC WATER LEVEL: **26.84** ft. below land surface measured on mo/day/yr **11-03-93**
 Pump test data: Well water was **NA** ft. after — hours pumping — gpm
 Est. Yield **NA** gpm Well water was — ft. after — hours pumping — gpm
 Bore Hole Diameter: **7.25** in. to **50** ft. and — in. to — ft.
 WELL WATER TO BE USED AS:
 5 Public water supply 8 Air conditioning 11 Injection well
 1 Domestic 3 Feedlot 6 Oil field water supply 9 Dewatering 12 Other (Specify below)
 2 Irrigation 4 Industrial 7 Lawn and garden only 10 Monitoring well
 Was a chemical/bacteriological sample submitted to Department? Yes — No **X**; If yes, mo/day/yr sample was submitted
 Water Well Disinfected? Yes — No **X**

5 TYPE OF BLANK CASING USED:
 1 Steel 3 RMP (SR) 5 Wrought iron 8 Concrete tile CASING JOINTS: Glued — Clamped —
 2 PVC 4 ABS 6 Asbestos-Cement 9 Other (specify below) Welded —
 7 Fiberglass Threaded **X**
 Blank casing diameter **2** in. to **2.4** ft. Dia — in. to — ft. Dia — in. to — ft.
 Casing height above land surface **24** in. weight **SCH 40** lbs./ft. Wall thickness or gauge No. —
 TYPE OF SCREEN OR PERFORATION MATERIAL:
 1 Steel 3 Stainless steel 5 Fiberglass 7 PVC 10 Asbestos-cement
 2 Brass 4 Galvanized steel 6 Concrete tile 8 RMP (SR) 11 Other (specify) —
 9 ABS 12 None used (open hole)
 SCREEN OR PERFORATION OPENINGS ARE:
 1 Continuous slot 3 Mill slot 5 Gauzed wrapped 8 Saw cut 11 None (open hole)
 2 Louvered shutter 4 Key punched 6 Wire wrapped 9 Drilled holes
 7 Torch cut 10 Other (specify) —
 SCREEN-PERFORATED INTERVALS: From **2.4** ft. to **44.2** ft. From — ft. to — ft.
SAND From — ft. to — ft. From — ft. to — ft.
~~GRAVEL~~ PACK INTERVALS: From **21.7** ft. to **50** ft. From — ft. to — ft.

6 GROUT MATERIAL: 1 Neat cement 2 Cement grout 3 Bentonite 4 Other —
 Grout Intervals: From **6.4** ft. to **15.8** ft. From **15.8** ft. to **21.7** ft. From — ft. to — ft.
 What is the nearest source of possible contamination:
 1 Septic tank 4 Lateral lines 7 Pit privy 10 Livestock pens 14 Abandoned water well
 2 Sewer lines 5 Cess pool 8 Sewage lagoon 11 Fuel storage 15 Oil well/Gas well
 3 Watertight sewer lines 6 Seepage pit 9 Feedyard 12 Fertilizer storage 16 Other (specify below)
 13 Insecticide storage **CONTAMINATED SITE**
 Direction from well? — How many feet? —

FROM	TO	LITHOLOGIC LOG	FROM	TO	PLUGGING INTERVALS
6L	5	SOIL-CLAY SILT BROWN			NOTE: HAND DUG WELL N+W OF MW 25 HAS MANY GAL. OF FREE GAS.
5	13	SILTY CLAY - TAN			
13	28	CLAY SILT - GRAY			
28	34	SANDY CLAY - GAS-ODOR			
34	35	SAND-WITH CLAY			
35	43	CLAY SAND GRAY			
43	50	CLAY SAND - GRAY - FINE TO COARSE			

7 CONTRACTOR'S OR LANDOWNER'S CERTIFICATION: This water well was (1) constructed, (2) reconstructed, or (3) plugged under my jurisdiction and was completed on (mo/day/year) **10-22-93** and this record is true to the best of my knowledge and belief. Kansas Water Well Contractor's License No. **479** This Water Well Record was completed on (mo/day/yr) **12-17-93** under the business name of **EBBERTS DRILLING** by (signature) *Gregory Ebberts*

INSTRUCTIONS: Use typewriter or ball point pen. PLEASE PRESS FIRMLY and PRINT clearly. Please fill in blanks, underline or circle the correct answers. Send top three copies to Kansas Department of Health and Environment, Bureau of Water, Topeka, Kansas 66620-0001. Telephone: 913-296-5545. Send one to WATER WELL OWNER and retain one for your records.

LATE FILE WAIVER PER PH CALL WITH D.T. 11-19-93

OFFICE USE ONLY T R EW SEC 1/4 1/4 1/4