


1 LOCATION OF WATER WELL: Fraction SW 1/4 SE 1/4 SW 1/4 Section Number 30 Township Number T 18 S Range Number R 23 E
 County: NESS

Distance and direction from nearest town or city street address of well if located within city?
E-SIDE COURT ST - N OF R.R.

2 WATER WELL OWNER: HOME OIL CO - HAROLD GABLE
 RR#, St. Address, Box #: 301 W SYCAMORE NESS CITY KS 67560 Board of Agriculture, Division of Water Resources
 City, State, ZIP Code: NESS CITY KS 67560 Application Number:

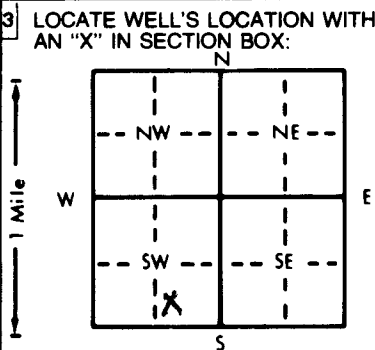

4 DEPTH OF COMPLETED WELL: 50 ft. ELEVATION: _____
 Depth(s) Groundwater Encountered: 46 ft. 2. _____ ft. 3. _____ ft.
 WELL'S STATIC WATER LEVEL: X ft. below land surface measured on mo/day/yr 11-03-93
 Pump test data: Well water was NA ft. after _____ hours pumping _____ gpm
 Est. Yield NA gpm: Well water was _____ ft. after _____ hours pumping _____ gpm
 Bore Hole Diameter: 7.25 in. to 50 ft. and _____ in. to _____ ft.
 WELL WATER TO BE USED AS:
 5 Public water supply 8 Air conditioning 11 Injection well
 1 Domestic 3 Feedlot 6 Oil field water supply 9 Dewatering 12 Other (Specify below)
 2 Irrigation 4 Industrial 7 Lawn and garden only 10 Monitoring well
 Was a chemical/bacteriological sample submitted to Department? Yes _____ No X; If yes, mo/day/yr sample was submitted _____
 Water Well Disinfected? Yes _____ No X

5 TYPE OF BLANK CASING USED:
 1 Steel 3 RMP (SR) 5 Wrought iron 8 Concrete tile CASING JOINTS: Glued _____ Clamped _____
2 PVC 4 ABS 7 Fiberglass _____ Welded _____
 Blank casing diameter: 2 in. to 29 ft. Dia _____ in. to _____ ft. Dia _____ in. to _____ ft.
 Casing height above land surface: FLUSH in., weight SCH 40 lbs./ft. Wall thickness or gauge No. _____
 TYPE OF SCREEN OR PERFORATION MATERIAL:
 1 Steel 3 Stainless steel 5 Fiberglass 7 PVC 10 Asbestos-cement
 2 Brass 4 Galvanized steel 6 Concrete tile 8 RMP (SR) 11 Other (specify) _____
 9 ABS 12 None used (open hole)
 SCREEN OR PERFORATION OPENINGS ARE:
 1 Continuous slot 3 Mill slot 5 Gauzed wrapped 8 Saw cut 11 None (open hole)
 2 Louvered shutter 4 Key punched 6 Wire wrapped 9 Drilled holes
 7 Torch cut 10 Other (specify) _____
 SCREEN-PERFORATED INTERVALS: From 29 ft. to 49.2 ft. From _____ ft. to _____ ft.
SAND From _____ ft. to _____ ft. From _____ ft. to _____ ft.
~~GRAVEL~~ PACK INTERVALS: From 28 ft. to 50 ft. From _____ ft. to _____ ft.
 From _____ ft. to _____ ft. From _____ ft. to _____ ft.

6 GROUT MATERIAL: 1 Neat cement 2 Cement grout 3 Bentonite 4 Other _____
 Grout Intervals: 2 From GL ft. to 26 ft. From 26 ft. to 28 ft. From _____ ft. to _____ ft.
 What is the nearest source of possible contamination:
 1 Septic tank 4 Lateral lines 7 Pit privy 10 Livestock pens 14 Abandoned water well
 2 Sewer lines 5 Cess pool 8 Sewage lagoon 11 Fuel storage 15 Oil well/Gas well
 3 Watertight sewer lines 6 Seepage pit 9 Feedyard 12 Fertilizer storage 16 Other (specify below)
 13 Insecticide storage CONTAMINATED SITE

Direction from well? _____ How many feet? _____

FROM	TO	LITHOLOGIC LOG	FROM	TO	PLUGGING INTERVALS
<u>0L</u>	<u>2</u>	<u>SOIL - CLAY SILT BROWN</u>			<u>* 2" PVC MECH PROBLEM</u>
<u>2</u>	<u>9</u>	<u>CLAY SILT - TAN</u>			<u>1.65" O.D. BAILER</u>
<u>9</u>	<u>12</u>	<u>SILTY CLAY - GRAY</u>			<u>WOULD NOT GO TO WATER</u>
<u>12</u>	<u>26</u>	<u>CLAY SILT - TAN</u>			<u>PROBE WOULD NOT GO</u>
<u>26</u>	<u>35</u>	<u>SANDY CLAY - TAN</u>			<u>THROUGH 2" THREADED</u>
<u>35</u>	<u>38</u>	<u>CLAY SAND - TAN</u>			<u>CON.</u>
<u>38</u>	<u>41</u>	<u>SANDY CLAY</u>			
<u>41</u>	<u>46</u>	<u>CLAY SAND</u>			
<u>46</u>	<u>49.5</u>	<u>SAND - FINE / COARSE</u>			
<u>49.5</u>	<u>50</u>	<u>SHALE - D. GRAY - DRY - HARD</u>			
<u>TD</u>	<u>50</u>				

7 CONTRACTOR'S OR LANDOWNER'S CERTIFICATION: This water well was (1) constructed, (2) reconstructed, or (3) plugged under my jurisdiction and was completed on (mo/day/year) 10-21-93 and this record is true to the best of my knowledge and belief. Kansas Water Well Contractor's License No. 479 This Water Well Record was completed on (mo/day/yr) 12-17-93 under the business name of EBBERTS DRILLING by (signature) Susan Ebberts

INSTRUCTIONS: Use typewriter or ball point pen. PLEASE PRESS FIRMLY and PRINT clearly. Please fill in blanks, underline or circle the correct answers. Send top three copies to Kansas Department of Health and Environment, Bureau of Water, Topeka, Kansas 66620-0001. Telephone: 913-296-5545. Send one to WATER WELL OWNER and retain one for your records.

LATE FILE WAIVER PER PH CALL WITH DT. 11-19-93

OFFICE USE ONLY

T

R

EW

SEC.

1/4

1/4

1/4