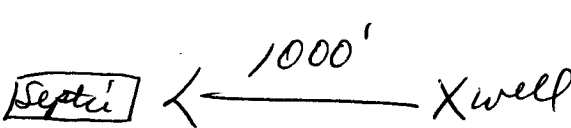


USE TYPEWRITER OR BALL
POINT PEN-PRESS FIRMLY,
PRINT CLEARLY.

WATER WELL RECORD
KSA 82a-1201-1215

Kansas Department of Health and
Environment-Division of Environment
(Water well Contractors)
Topeka, Kansas 66620

Sent to BWS
1-10-79

1. Location of well:	County Ness	Fraction NW 1/4 SW 1/4 NW 1/4	Section number 30	Township number T 18 S	Range number R 23 E
2. Distance and direction from nearest town or city: In Ness City			3. Owner of well: City of Ness City		
Street address of well location if in city:			R.R. or street: City, state, zip code: Ness City, KS 67560		
4. Locate with "X" in section below: N W E S 1 Mile		Sketch map: 		6. Bore hole dia. 24 in. Completion date Well depth 56 ft. 12-31-75	
5. Type and color of material		From	To	7. Cable tool <input type="checkbox"/> Rotary <input type="checkbox"/> Driven <input type="checkbox"/> Dug <input type="checkbox"/> Hollow rod <input type="checkbox"/> Jetted <input type="checkbox"/> Bored <input checked="" type="checkbox"/> Reverse rotary	
#20 Well				8. Use: <input type="checkbox"/> Domestic <input checked="" type="checkbox"/> Public supply <input type="checkbox"/> Industry <input type="checkbox"/> Irrigation <input type="checkbox"/> Air conditioning <input type="checkbox"/> Stock <input type="checkbox"/> Lawn <input type="checkbox"/> Oil field water <input type="checkbox"/> Other	
Clay		0	42	9. Casing: Material Steel Height Above or below Threaded <input type="checkbox"/> Welded <input checked="" type="checkbox"/> Surface 30 in. RMP <input type="checkbox"/> PVC <input type="checkbox"/> Weight 41.51 lbs./ft. Dia. 12 in. to 56 ft. depth Wall Thickness: inches or Dia. <input type="checkbox"/> in. to <input type="checkbox"/> ft. depth gage No. .312	
Sand		42	56	10. Screen: Manufacturer's name Cook Type Stainless Steel 12 in. Slot gauge 100 Length 10 ft. Set between 46 ft. and 56 ft. ft. and <input type="checkbox"/> ft. Gravel pack? yes Size range of material 1/2-1	
Shale		56	57	11. Static water level: 31 ft. below land surface Date 12-31-74 mo./day/yr.	
AP 56' from				12. Pumping level below land surfaces: 44 ft. after 8 hrs. pumping 150 g.p.m. ft. after <input type="checkbox"/> hrs. pumping <input type="checkbox"/> g.p.m. Estimated maximum yield 150 g.p.m.	
(Use a second sheet if needed)				20. Water well contractor's certification: This well was drilled under my jurisdiction and this report is true to the best of my knowledge and belief. Weishaar Drilling 232 Business name License No. Address Small St. KS 67871 Signature [Signature] Date 7-19-76 Authorized representative	
18. Elevation:	19. Remarks:				
Topography: <input type="checkbox"/> Hill <input checked="" type="checkbox"/> Slope <input type="checkbox"/> Upland <input type="checkbox"/> Valley					

Forward the white, blue and pink copies to the Department of Health and Environment

Form WWC-5