


1 LOCATION OF WATER WELL: Fraction **NE 1/4 SE 1/4 SW 1/4** Section Number **30** Township Number **T 18 S** Range Number **R 23 EW**
 County: **NESS**

Distance and direction from nearest town or city street address of well if located within city?
NE C BLOCK INT. SYCAMORE + COURT NESS CITY

2 WATER WELL OWNER: **HAROLD GABEL**
 RR#, St. Address, Box #: **301 WEST SYCAMORE NESS CITY KS 67560** Board of Agriculture, Division of Water Resources
 City, State, ZIP Code: Application Number:

3 LOCATE WELL'S LOCATION WITH AN "X" IN SECTION BOX:

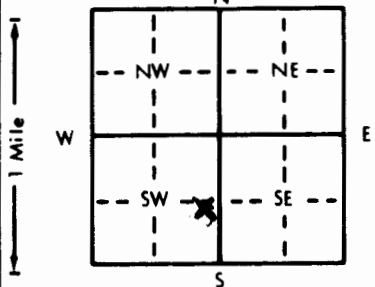

4 DEPTH OF COMPLETED WELL: **53.5** ft. ELEVATION: **2256.79**

Depth(s) Groundwater Encountered 1. **46.2** ft. 2. **-** ft. 3. **-** ft.
 WELL'S STATIC WATER LEVEL **46.17** ft. below land surface measured on mo/day/yr **08-26-92**
NA Pump test data: Well water was **-** ft. after **-** hours pumping **-** gpm
 Est. Yield **UNKNOWN** gpm: Well water was **-** ft. after **-** hours pumping **-** gpm
 Bore Hole Diameter: **11.75** in. to **53.5** ft. and **-** in. to **-** ft.
 WELL WATER TO BE USED AS:
 5 Public water supply 8 Air conditioning 11 Injection well
 1 Domestic 3 Feedlot 6 Oil field water supply 9 Dewatering 12 Other (Specify below)
 2 Irrigation 4 Industrial 7 Lawn and garden only **10 Monitoring well**
 Was a chemical/bacteriological sample submitted to Department? Yes **-** No **X**; If yes, mo/day/yr sample was submitted
 Water Well Disinfected? Yes **-** No **X**

5 TYPE OF BLANK CASING USED:
 1 Steel 3 RMP (SR) 5 Wrought iron 8 Concrete tile CASING JOINTS: Glued **-** Clamped **-**
 2 PVC 4 ABS 6 Asbestos-Cement 9 Other (specify below) Welded **-**
 7 Fiberglass Threaded **X**

Blank casing diameter **2** in. to **33.5** ft. Dia **2" SCREEN** to **53.5** ft. Dia **-** in. to **-** ft.
 Casing height above land surface **66** in., weight **SCH 40** lbs./ft. Wall thickness or gauge No. **-**

TYPE OF SCREEN OR PERFORATION MATERIAL:
 1 Steel 3 Stainless steel 5 Fiberglass 7 PVC 10 Asbestos-cement
 2 Brass 4 Galvanized steel 6 Concrete tile 8 RMP (SR) 11 Other (specify) **-**
 9 ABS 12 None used (open hole)

SCREEN OR PERFORATION OPENINGS ARE:
 1 Continuous slot 3 Mill slot 5 Gauzed wrapped 8 Saw cut 11 None (open hole)
 2 Louvered shutter 4 Key punched 6 Wire wrapped 9 Drilled holes
 7 Torch cut 10 Other (specify) **-**

SCREEN-PERFORATED INTERVALS: From **33.5** ft. to **53.5** ft., From **-** ft. to **-** ft.
SAND From **32.5** ft. to **53.5** ft., From **-** ft. to **-** ft.
GRAVEL PACK INTERVALS: From **32.5** ft. to **53.5** ft., From **-** ft. to **-** ft.

6 GROUT MATERIAL: 1 Neat cement 2 Cement grout 3 Bentonite 4 Other **-**
 Grout intervals: From **32.5** ft. to **53.5** ft., From **-** ft. to **-** ft., From **-** ft. to **-** ft.

What is the nearest source of possible contamination:
 1 Septic tank 4 Lateral lines 7 Pit privy 10 Livestock pens 14 Abandoned water well
 2 Sewer lines 5 Cess pool 8 Sewage lagoon 11 Fuel storage 15 Oil well/Gas well
 3 Watertight sewer lines 6 Seepage pit 9 Feedyard 12 Fertilizer storage 16 Other (specify below) **WELL CONTAMINATED**
 13 Insecticide storage

Direction from well? **-** How many feet? **-**

FROM	TO	LITHOLOGIC LOG	FROM	TO	PLUGGING INTERVALS
0	7	SILTY CLAY - FILL			FLUCH MOUNT
7	16	CLAY SILT - TAN			
16	20	CLAY SILT - SD LENSE - FINE TO COARSE			
20	25	FINE SD - CONTAMINATED -			
25	32	SD - CLAY - LENSES - FINE TO COARSE			
32	35	SILTY CLAY - SCT - GRAVEL - SD			
35	37	GREEN GREY CLAY			
37	40	GREEN GREY CLAY WITH IRON STAINS			
40	47	SANDS + GRAVELS - GREEN GREY TO TAN			
47	53.5	COARSE TO FINE CONTAMINATED			
		CATSISLE SHALE			

7 CONTRACTOR'S OR LANDOWNER'S CERTIFICATION: This water well was (1) constructed, (2) reconstructed, or (3) plugged under my jurisdiction and was completed on (mo/day/year) **08-18-92** and this record is true to the best of my knowledge and belief. Kansas Water Well Contractor's License No. **479** This Water Well Record was completed on (mo/day/yr) **09-19-92** under the business name of **EBBERTS DRILLING** by (signature) **Arjan West**

OFFICE USE ONLY
T
R
EW
SEC.