


1 LOCATION OF WATER WELL: Fraction **NE 1/4 SE 1/4 SW 1/4** Section Number **30** Township Number **T 18 S** Range Number **R 23 EW**
 County: **NESS**

Distance and direction from nearest town or city street address of well if located within city?
N W COR BLOCK AT MAIN + FRANKLIN CT NESS CITY

2 WATER WELL OWNER: **HAROLD GABEL**
 RR#, St. Address, Box #: **301 W. SYCAMORE NESS CITY KS 67560** Board of Agriculture, Division of Water Resources
 City, State, ZIP Code: Application Number:

3 LOCATE WELL'S LOCATION WITH AN "X" IN SECTION BOX:

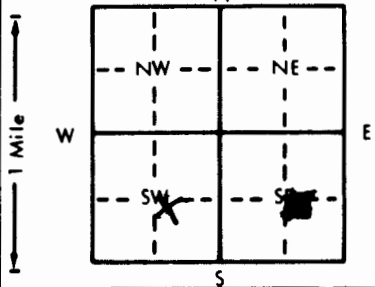

4 DEPTH OF COMPLETED WELL: **40** ft. ELEVATION: **2248.51**
 Depth(s) Groundwater Encountered 1. **35** ft. 2. **-** ft. 3. **-** ft.
 WELL'S STATIC WATER LEVEL **32.15** ft. below land surface measured on mo/day/yr **08-26-92**
 NA Pump test data: Well water was **-** ft. after **-** hours pumping **-** gpm
 Est. Yield **UNKNOWN** gpm: Well water was **-** ft. after **-** hours pumping **-** gpm
 Bore Hole Diameter: **11.75** in. to **40** ft. and **-** in. to **-** ft.
 WELL WATER TO BE USED AS:
 5 Public water supply 8 Air conditioning 11 Injection well
 1 Domestic 3 Feedlot 6 Oil field water supply 9 Dewatering 12 Other (Specify below)
 2 Irrigation 4 Industrial 7 Lawn and garden only **10 Monitoring well**
 Was a chemical/bacteriological sample submitted to Department? Yes **-** No **X**; If yes, mo/day/yr sample was submitted
 Water Well Disinfected? Yes **-** No **X**

5 TYPE OF BLANK CASING USED:
 1 Steel 3 RMP (SR) 5 Wrought iron 8 Concrete tile CASING JOINTS: Glued **-** Clamped **-**
2 PVC 4 ABS 6 Asbestos-Cement 9 Other (specify below) Welded **-**
 7 Fiberglass Threaded **X**

Blank casing diameter **6 1/2** in. to **20** ft. Dia **2" SCREEN TO 40** ft. Dia **-** in. to **-** ft.
 Casing height above land surface **6L** in., weight **SC4 40** lbs./ft. Wall thickness or gauge No. **-**

TYPE OF SCREEN OR PERFORATION MATERIAL:
 1 Steel 3 Stainless steel 5 Fiberglass 7 PVC 10 Asbestos-cement
 2 Brass 4 Galvanized steel 6 Concrete tile 8 RMP (SR) 11 Other (specify) **-**
 12 None used (open hole)

SCREEN OR PERFORATION OPENINGS ARE:
 1 Continuous slot **3 Mill slot** 5 Gauzed wrapped 8 Saw cut 11 None (open hole)
 2 Louvered shutter 4 Key punched 6 Wire wrapped 9 Drilled holes
 7 Torch cut 10 Other (specify) **-**

SCREEN-PERFORATED INTERVALS: From **20** ft. to **40** ft. From **-** ft. to **-** ft. From **-** ft. to **-** ft.
SAND
 GRAVEL PACK INTERVALS: From **19** ft. to **40** ft. From **-** ft. to **-** ft. From **-** ft. to **-** ft.

6 GROUT MATERIAL: 1 Neat cement 2 Cement grout **3 Bentonite** 4 Other **-**
 Grout intervals: From **5** ft. to **19** ft. From **-** ft. to **-** ft. From **-** ft. to **-** ft.

What is the nearest source of possible contamination:
 1 Septic tank 4 Lateral lines 7 Pit privy 10 Livestock pens 14 Abandoned water well
 2 Sewer lines 5 Cess pool 8 Sewage lagoon 11 Fuel storage 15 Oil well/Gas well
 3 Watertight sewer lines 6 Seepage pit 9 Feedyard 12 Fertilizer storage 16 Other (specify below) **WELL CONTAMINATED**
 13 Insecticide storage

Direction from well? **-** How many feet? **-**

FROM	TO	LITHOLOGIC LOG	FROM	TO	PLUGGING INTERVALS
0	2.2	FILL - LS + CONCRETE - CLAY			FLUSH MOUNT
2.2	20	SILTY CLAY			
20	25	CLAYEY SAND			
25	39.6	LAYERS OF SAND - CLAY - FINE TO COARSE - SCT. GRAVEL - WATER - 35-			
39.6	40	SHALE - DRK GRAY -			

7 CONTRACTOR'S OR LANDOWNER'S CERTIFICATION: This water well was **(1) constructed**, (2) reconstructed, or (3) plugged under my jurisdiction and was completed on (mo/day/year) **08-13-92** and this record is true to the best of my knowledge and belief. Kansas Water Well Contractor's License No. **479** This Water Well Record was completed on (mo/day/yr) **09-10-92** under the business name of **EBBERTS DRILLING** by (signature) *Stephen Ebberts*

OFFICE USE ONLY
T
R
EW
SEC.