


1 LOCATION OF WATER WELL: Fraction SW 1/4 NE 1/4 SW 1/4 Section Number 30 Township Number T 18 S Range Number R 23 E/W
 County: NESS

Distance and direction from nearest town or city street address of well if located within city?
W SIDE FRANKLIN ST NORTH OF SYCAMORE ST NESS CITY

2 WATER WELL OWNER: HAROLD GABEL
 RR#, St. Address, Box # 301 W SYCAMORE NESS CITY KS 67820 Board of Agriculture, Division of Water Resources
 City, State, ZIP Code Application Number:

3 LOCATE WELL'S LOCATION WITH AN "X" IN SECTION BOX:

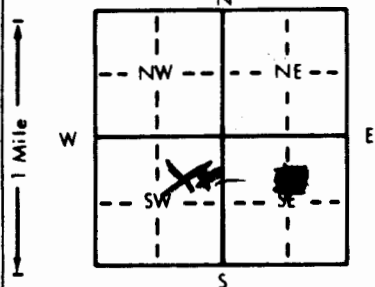

4 DEPTH OF COMPLETED WELL: 37 ft. ELEVATION: 2243.98
 Depth(s) Groundwater Encountered 1. 34.2 ft. 2. - ft. 3. - ft.
 WELL'S STATIC WATER LEVEL 33.22 ft. below land surface measured on mo/day/yr 08-26-92
 Pump test data: Well water was - ft. after - hours pumping - gpm
 Est. Yield UNKNOWN gpm: Well water was - ft. after - hours pumping - gpm
 Bore Hole Diameter 11.75 in. to 37 ft. and - in. to - ft.
 WELL WATER TO BE USED AS:
 5 Public water supply 8 Air conditioning 11 Injection well
 1 Domestic 3 Feedlot 6 Oil field water supply 9 Dewatering 12 Other (Specify below)
 2 Irrigation 4 Industrial 7 Lawn and garden only 10 Monitoring well
 Was a chemical/bacteriological sample submitted to Department? Yes - No X; If yes, mo/day/yr sample was submitted
 Water Well Disinfected? Yes - No X

5 TYPE OF BLANK CASING USED:
 1 Steel 3 RMP (SR) 5 Wrought iron 8 Concrete tile CASING JOINTS: Glued - Clamped -
 2 PVC 4 ABS 6 Asbestos-Cement 9 Other (specify below) Welded -
 7 Fiberglass Threaded X
 Blank casing diameter 2 in. to 17 ft. Dia 2" SCREEN to 37 ft. Dia - in. to - ft.
 Casing height above land surface 6L in., weight SCH 40 lbs./ft. Wall thickness or gauge No. -
 TYPE OF SCREEN OR PERFORATION MATERIAL:
 1 Steel 3 Stainless steel 5 Fiberglass 7 PVC 10 Asbestos-cement
 2 Brass 4 Galvanized steel 6 Concrete tile 8 RMP (SR) 11 Other (specify) -
 12 None used (open hole)
 SCREEN OR PERFORATION OPENINGS ARE:
 1 Continuous slot 3 Mill slot 5 Gauzed wrapped 8 Saw cut 11 None (open hole)
 2 Louvered shutter 4 Key punched 6 Wire wrapped 9 Drilled holes
 7 Torch cut 10 Other (specify) -
 SCREEN-PERFORATED INTERVALS: From 17 ft. to 37 ft. From - ft. to - ft.
 From - ft. to - ft. From - ft. to - ft.
 SAND GRAVEL PACK INTERVALS: From 16 ft. to 37 ft. From - ft. to - ft.
 From - ft. to - ft. From - ft. to - ft.

6 GROUT MATERIAL: 1 Neat cement 2 Cement grout 3 Bentonite 4 Other -
 Grout Intervals: From 5 ft. to 16 ft. From - ft. to - ft. From - ft. to - ft.
 What is the nearest source of possible contamination:
 1 Septic tank 4 Lateral lines 7 Pit privy 10 Livestock pens 14 Abandoned water well
 2 Sewer lines 5 Cess pool 8 Sewage lagoon 11 Fuel storage 15 Oil well/Gas well
 3 Watertight sewer lines 6 Seepage pit 9 Feedyard 12 Fertilizer storage 16 Other (specify below)
13 Insecticide storage WELL CONTAMINATED

Direction from well? - How many feet?

FROM	TO	LITHOLOGIC LOG	FROM	TO	PLUGGING INTERVALS
<u>0</u>	<u>1.5</u>	<u>SOIL</u>			<u>FLUSH MOUNT</u>
<u>1.5</u>	<u>20.6</u>	<u>SILTY CLAY</u>			
<u>20.6</u>	<u>27</u>	<u>SAND-SANDY CLAY-TAN-LAYERS</u>			
<u>27</u>	<u>34.2</u>	<u>CLAYEY SILT</u>			
<u>34.2</u>	<u>37</u>	<u>SAND</u>			
<u>37</u>		<u>SHALE DK GREY</u>			

7 CONTRACTOR'S OR LANDOWNER'S CERTIFICATION: This water well was (1) constructed, (2) reconstructed, or (3) plugged under my jurisdiction and was completed on (mo/day/year) 08-13-92 and this record is true to the best of my knowledge and belief. Kansas Water Well Contractor's License No. 479 This Water Well Record was completed on (mo/day/yr) 09-10-92 under the business name of EBBERTS DRILLING by (signature) Arjona Ebberts

OFFICE USE ONLY
T
R
EW
SEC.
1/4
1/4
1/4