


1 LOCATION OF WATER WELL: Fraction SW 1/4 NE 1/4 SW 1/4 Section Number 30 Township Number T 18 S Range Number R 23 E/W
 County: NESS

Distance and direction from nearest town or city street address of well if located within city?
W SIDE OF FRANKLIN ST S OF SYCAMORE ST NESS CITY

2 WATER WELL OWNER: HAROLD GABEL
 RR#, St. Address, Box # 301 W - SYCAMORE ST. NESS CITY KS 67560 Board of Agriculture, Division of Water Resources
 City, State, ZIP Code Application Number:

3 LOCATE WELL'S LOCATION WITH AN "X" IN SECTION BOX:

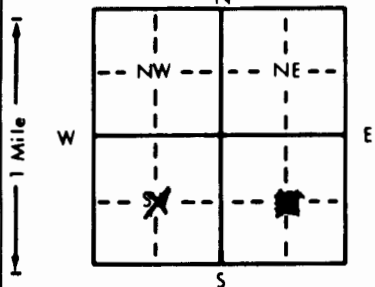

4 DEPTH OF COMPLETED WELL 41.8 ft. ELEVATION: 2245.3
 Depth(s) Groundwater Encountered 1. 36 ft. 2. --- ft. 3. --- ft.
 WELL'S STATIC WATER LEVEL 36.83 ft. below land surface measured on mo/day/yr 08-26-92
 NA Pump test data: Well water was --- ft. after --- hours pumping --- gpm
 Est. Yield UNKNOWN gpm: Well water was --- ft. after --- hours pumping --- gpm
 Bore Hole Diameter 7.25 in. to 41.8 ft. and --- in. to --- ft.
 WELL WATER TO BE USED AS: 5 Public water supply 8 Air conditioning 11 Injection well
 1 Domestic 3 Feedlot 6 Oil field water supply 9 Dewatering 12 Other (Specify below)
 2 Irrigation 4 Industrial 7 Lawn and garden only 10 Monitoring well
 Was a chemical/bacteriological sample submitted to Department? Yes --- No X; If yes, mo/day/yr sample was submitted ---
 Water Well Disinfected? Yes --- No X

5 TYPE OF BLANK CASING USED: 5 Wrought iron 8 Concrete tile CASING JOINTS: Glued --- Clamped ---
 1 Steel 3 RMP (SR) 6 Asbestos-Cement 9 Other (specify below) Welded ---
2 PVC 4 ABS 7 Fiberglass Threaded X

Blank casing diameter 2 in. to 21.8 ft. Dia 2" SCREW to 41.8 ft. Dia --- in. to --- ft.
 Casing height above land surface 18 in. weight SCW 40 lbs./ft. Wall thickness or gauge No. ---

TYPE OF SCREEN OR PERFORATION MATERIAL: 7 PVC 10 Asbestos-cement
 1 Steel 3 Stainless steel 5 Fiberglass 8 RMP (SR) 11 Other (specify) ---
 2 Brass 4 Galvanized steel 6 Concrete tile 9 ABS 12 None used (open hole)

SCREEN OR PERFORATION OPENINGS ARE: 5 Gauzed wrapped 8 Saw cut 11 None (open hole)
 1 Continuous slot 3 Mill slot 6 Wire wrapped 9 Drilled holes
 2 Louvered shutter 4 Key punched 7 Torch cut 10 Other (specify) ---

SCREEN-PERFORATED INTERVALS: From 21.8 ft. to 41.8 ft. From --- ft. to --- ft.
SAND From --- ft. to --- ft. From --- ft. to --- ft.
~~GRAVEL~~ PACK INTERVALS: From 20.8 ft. to 41.8 ft. From --- ft. to --- ft.

6 GROUT MATERIAL: 1 Neat cement 2 Cement grout 3 Bentonite 4 Other ---
 Grout Intervals: From --- ft. to 20.8 ft. From --- ft. to --- ft. From --- ft. to --- ft.

What is the nearest source of possible contamination:
 1 Septic tank 4 Lateral lines 7 Pit privy 10 Livestock pens 14 Abandoned water well
 2 Sewer lines 5 Cess pool 8 Sewage lagoon 11 Fuel storage 15 Oil well/Gas well
 3 Watertight sewer lines 6 Seepage pit 9 Feedyard 12 Fertilizer storage 16 Other (specify below)
CONTAMINATED WELL
 Direction from well? --- How many feet? ---

FROM	TO	LITHOLOGIC LOG	FROM	TO	PLUGGING INTERVALS
0	1.8	CLAY-GRAVEL-FILL			
1.8	13.3	CLAY SILT			
13.3	18.3	CLAY SILT WITH FINE TO M. SD.			
18.3	25.3	CLAY SILT SCT. SD + CALCAREOUS GRAVEL			
25.3	35	SDY CLAY LT GREY			
35	36	CLAY - GREEN GRAY			
36	36.3	SD - FINE TO MED - WATER			
36.3	37	GREEN GRAY SILT CLAY			
37.3	40.7	SD + GRAVEL - WATER			
40.7	41.8	WEATHERED SHALE			
41.8		CAPSKLE SHALE			

7 CONTRACTOR'S OR LANDOWNER'S CERTIFICATION: This water well was (1) constructed, (2) reconstructed, or (3) plugged under my jurisdiction and was completed on (mo/day/year) 08-19-92 and this record is true to the best of my knowledge and belief. Kansas Water Well Contractor's License No. 479 This Water Well Record was completed on (mo/day/yr) 09-19-92 under the business name of EBBERTS DRILLING by (signature) Jean Elbert

OFFICE USE ONLY
T
R
EW
SEC.