


1 LOCATION OF WATER WELL: Fraction NE 1/4 SE 1/4 SW 1/4 Section Number 30 Township Number T 18 S Range Number R 23 EW
 County: NESS

Distance and direction from nearest town or city street address of well if located within city?
S-CENTER-BLOCK-N OF SYCAMORE ST. NESS CITY

2 WATER WELL OWNER: HAROLD GABEL
 RR#, St. Address, Box #: 301 WEST SYCAMORE NESS CITY KS. 67560 Board of Agriculture, Division of Water Resources
 City, State, ZIP Code: Application Number: -

3 LOCATE WELL'S LOCATION WITH AN "X" IN SECTION BOX:

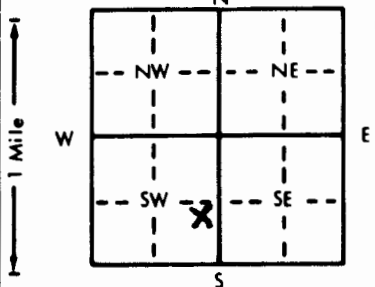

4 DEPTH OF COMPLETED WELL: 51.6 ft. ELEVATION: 2255.58

Depth(s) Groundwater Encountered 1. 46 ft. 2. - ft. 3. - ft.
 WELL'S STATIC WATER LEVEL 44.17 ft. below land surface measured on mo/day/yr 08-26-92
 Pump test data: Well water was NA ft. after - hours pumping - gpm
 Est. Yield UNKNOWN gpm: Well water was - ft. after - hours pumping - gpm
 Bore Hole Diameter: 11.75 in. to 51.6 ft. and - in. to - ft.
 WELL WATER TO BE USED AS:
 5 Public water supply 8 Air conditioning 11 Injection well
 1 Domestic 3 Feedlot 6 Oil field water supply 9 Dewatering 12 Other (Specify below)
 2 Irrigation 4 Industrial 7 Lawn and garden only 10 Monitoring well
 Was a chemical/bacteriological sample submitted to Department? Yes - No X; If yes, mo/day/yr sample was submitted -
 Water Well Disinfected? Yes - No X

5 TYPE OF BLANK CASING USED:
 1 Steel 3 RMP (SR) 5 Wrought iron 8 Concrete tile CASING JOINTS: Glued - Clamped -
 2 PVC 4 ABS 6 Asbestos-Cement 9 Other (specify below) Welded -
 7 Fiberglass Threaded X

Blank casing diameter 2 in. to 31.6 ft. Dia 2" SCREEN to 51.6 ft. Dia - in. to - ft.
 Casing height above land surface 61 in., weight SCM 40 lbs./ft. Wall thickness or gauge No. -

TYPE OF SCREEN OR PERFORATION MATERIAL:
 1 Steel 3 Stainless steel 5 Fiberglass 7 PVC 10 Asbestos-cement
 2 Brass 4 Galvanized steel 6 Concrete tile 8 RMP (SR) 11 Other (specify) -
 9 ABS 12 None used (open hole)

SCREEN OR PERFORATION OPENINGS ARE:
 1 Continuous slot 3 Mill slot 5 Gauzed wrapped 8 Saw cut 11 None (open hole)
 2 Louvered shutter 4 Key punched 6 Wire wrapped 9 Drilled holes
 7 Torch cut 10 Other (specify) X

SCREEN-PERFORATED INTERVALS: From 31.6 ft. to 51.6 ft. From - ft. to - ft.
 From - ft. to - ft. From - ft. to - ft.
 SAND GRAVEL PACK INTERVALS: From 30.6 ft. to 51.6 ft. From - ft. to - ft.
 From - ft. to - ft. From - ft. to - ft.

6 GROUT MATERIAL: 1 Neat cement 2 Cement grout 3 Bentonite 4 Other -
 Grout intervals: From -.5 ft. to 30.6 ft., From - ft. to - ft., From - ft. to - ft.

What is the nearest source of possible contamination:
 1 Septic tank 4 Lateral lines 7 Pit privy 10 Livestock pens 14 Abandoned water well
 2 Sewer lines 5 Cess pool 8 Sewage lagoon 11 Fuel storage 15 Oil well/Gas well
 3 Watertight sewer lines 6 Seepage pit 9 Feedyard 12 Fertilizer storage 16 Other (specify below) WELL-CONTAMINATED
 13 Insecticide storage

Direction from well? - How many feet? -

FROM	TO	LITHOLOGIC LOG	FROM	TO	PLUGGING INTERVALS
0	1	SOIL			FLUSH MOUNT
1	20	CLAY SILT-TAN			
20	25	CLAY SILT-TAN-FINE SD			
25	35	SAND			
35	45	SILTY CLAY			
45	46	SILTY CLAY - ODER			
46	47	SAND- CONTAMINATED			
47	51.6	SD-GRAVEL - WATER			
51.6		SHALE - BLACK			

7 CONTRACTOR'S OR LANDOWNER'S CERTIFICATION: This water well was (1) constructed, (2) reconstructed, or (3) plugged under my jurisdiction and was completed on (mo/day/year) 08 05 92 and this record is true to the best of my knowledge and belief. Kansas Water Well Contractor's License No. 479 This Water Well Record was completed on (mo/day/yr) 09-05-92 under the business name of EBBERTS DRILLING by signature August Elbert

OFFICE USE ONLY
T
R
EW
SEC.