


1 LOCATION OF WATER WELL: Fraction NE 1/4 NE 1/4 SW 1/4 Section Number 30 Township Number T 18 S Range Number R 23 EW
 County: NESS

Distance and direction from nearest town or city street address of well if located within city?
W-SIDE COURT ST - N OF SYCAMORE ST. NESS CITY

2 WATER WELL OWNER: HAROLD GABEL
 RR#, St. Address, Box # 301 W SYCAMORE NESS CITY KS. 67520 Board of Agriculture, Division of Water Resources
 City, State, ZIP Code Application Number:

3 LOCATE WELL'S LOCATION WITH AN "X" IN SECTION BOX:

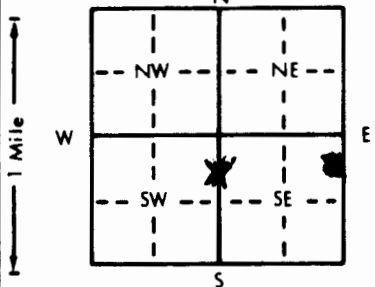

4 DEPTH OF COMPLETED WELL: 52.9 ft. ELEVATION: 2257.8
 Depth(s) Groundwater Encountered 1. 48.6 ft. 2. _____ ft. 3. _____ ft.
 WELL'S STATIC WATER LEVEL 49.13 ft. below land surface measured on mo/day/yr 08-26-92
 Pump test data: Well water was _____ ft. after _____ hours pumping _____ gpm
 Est. Yield UNKNOWN gpm: Well water was _____ ft. after _____ hours pumping _____ gpm
 Bore Hole Diameter: 7.25 in. to 52.9 ft. and _____ in. to _____ ft.
 WELL WATER TO BE USED AS:
 5 Public water supply 8 Air conditioning 11 Injection well
 1 Domestic 3 Feedlot 6 Oil field water supply 9 Dewatering 12 Other (Specify below)
 2 Irrigation 4 Industrial 7 Lawn and garden only 10 Monitoring well
 Was a chemical/bacteriological sample submitted to Department? Yes _____ No X; If yes, mo/day/yr sample was submitted _____
 Water Well Disinfected? Yes _____ No X

5 TYPE OF BLANK CASING USED:
 1 Steel 3 RMP (SR) 5 Wrought iron 8 Concrete tile CASING JOINTS: Glued _____ Clamped _____
 2 PVC 4 ABS 6 Asbestos-Cement 9 Other (specify below) Welded _____
 7 Fiberglass Threaded X

Blank casing diameter 2 in. to 32.9 ft. Dia 2" SCREEN to 52.9 ft. Dia _____ in. to _____ ft.
 Casing height above land surface 18 in., weight SCH 40 lbs./ft. Wall thickness or gauge No. _____

TYPE OF SCREEN OR PERFORATION MATERIAL:
 1 Steel 3 Stainless steel 5 Fiberglass 7 PVC 10 Asbestos-cement
 2 Brass 4 Galvanized steel 6 Concrete tile 8 RMP (SR) 11 Other (specify) _____
 9 ABS 12 None used (open hole)

SCREEN OR PERFORATION OPENINGS ARE:
 1 Continuous slot 3 Mill slot 5 Gauzed wrapped 8 Saw cut 11 None (open hole)
 2 Louvered shutter 4 Key punched 6 Wire wrapped 9 Drilled holes
 7 Torch cut 10 Other (specify) _____

SCREEN-PERFORATED INTERVALS: From 32.9 ft. to 52.9 ft. From _____ ft. to _____ ft.
 From _____ ft. to _____ ft. From _____ ft. to _____ ft.
 SAND GRAVEL PACK INTERVALS: From 31.9 ft. to 52.9 ft. From _____ ft. to _____ ft.
 From _____ ft. to _____ ft. From _____ ft. to _____ ft.

6 GROUT MATERIAL: 1 Neat cement 2 Cement grout 3 Bentonite 4 Other _____
 Grout Intervals: From .5 ft. to 31.9 ft. From _____ ft. to _____ ft. From _____ ft. to _____ ft.

What is the nearest source of possible contamination:
 1 Septic tank 4 Lateral lines 7 Pit privy 10 Livestock pens 14 Abandoned water well
 2 Sewer lines 5 Cess pool 8 Sewage lagoon 11 Fuel storage 15 Oil well/Gas well
 3 Watertight sewer lines 6 Seepage pit 9 Feedyard 12 Fertilizer storage 16 Other (specify below)
 13 Insecticide storage

Direction from well? SW How many feet? 100

FROM	TO	LITHOLOGIC LOG	FROM	TO	PLUGGING INTERVALS
<u>0</u>	<u>5</u>	<u>SILT-CLAY FILL MATERIAL</u>			<u>CLEAN CONTAMINATION TO</u>
<u>5</u>	<u>27</u>	<u>CLAY SILT TAN</u>			<u>THE S & W -</u>
<u>27</u>	<u>39</u>	<u>CLAY SILT - LT TAN - LEASE SAND</u>			
		<u>FINE TO COARSE S&T TALENTINE GRVL</u>			
<u>39</u>	<u>45</u>	<u>SILTY CLAY - GRAY - MDIST</u>			
<u>45</u>	<u>52.9</u>	<u>SANDY CLAY SAND</u>			
<u>52.9</u>		<u>TD - SHALE</u>			

7 CONTRACTOR'S OR LANDOWNER'S CERTIFICATION: This water well was (1) constructed, (2) reconstructed, or (3) plugged under my jurisdiction and was completed on (mo/day/year) 08-19-92 and this record is true to the best of my knowledge and belief. Kansas Water Well Contractor's License No. 479 This Water Well Record was completed on (mo/day/yr) 09-19-92 under the business name of EBBERTS DRILLING by (signature) Gregor Elbert

OFFICE USE ONLY
T
R
EW
SEC.