


1 LOCATION OF WATER WELL: County: **NESS** Fraction: **NE SE SW** Section Number: **30** Township Number: **T 18 S** Range Number: **R 23 EW**

Distance and direction from nearest town or city street address of well if located within city?
N CENTER OF BLOCK W M FRANKLIN + S IF MAIN NESS CITY

2 WATER WELL OWNER: **HAROLD GABEL**
 RR#, St. Address, Box #: **301 W. SYCAMORE NESS CITY KS 67560** Board of Agriculture, Division of Water Resources
 City, State, ZIP Code: Application Number: **-**

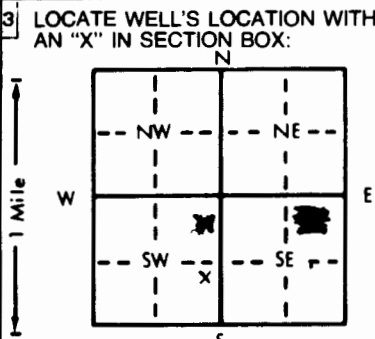

4 DEPTH OF COMPLETED WELL: **23.3** ft. ELEVATION: **-**
 Depth(s) Groundwater Encountered: 1. **NONE** ft. 2. **-** ft. 3. **-** ft.
 WELL'S STATIC WATER LEVEL: **NA** ft. below land surface measured on mo/day/yr **-**
 Pump test data: Well water was **-** ft. after **-** hours pumping **-** gpm
 Est. Yield **NA** gpm: Well water was **-** ft. after **-** hours pumping **-** gpm
 Bore Hole Diameter: **11.75** in. to **23.3** ft., and **-** in. to **-** ft.
 WELL WATER TO BE USED AS: **NA** 5 Public water supply 8 Air conditioning 11 Injection well
 1 Domestic 3 Feedlot 6 Oil field water supply 9 Dewatering 12 Other (Specify below)
 2 Irrigation 4 Industrial 7 Lawn and garden only 10 Monitoring well **-**
 Was a chemical/bacteriological sample submitted to Department? Yes **-** No **X**; If yes, mo/day/yr sample was submitted **-**
 Water Well Disinfected? Yes **-** No **X**

5 TYPE OF BLANK CASING USED: **NA** 5 Wrought iron 8 Concrete tile CASING JOINTS: Glued **-** Clamped **-**
 1 Steel 3 RMP (SR) 6 Asbestos-Cement 9 Other (specify below) Welded **-**
 2 PVC 4 ABS 7 Fiberglass Threaded **-**
 Blank casing diameter: **NA** in. to **-** ft., Dia. **-** in. to **-** ft., Dia. **-** in. to **-** ft.
 Casing height above land surface: **NA** in., weight **-** lbs./ft. Wall thickness or gauge No. **-**
 TYPE OF SCREEN OR PERFORATION MATERIAL: **NA** 7 PVC 10 Asbestos-cement
 1 Steel 3 Stainless steel 5 Fiberglass 8 RMP (SR) 11 Other (specify) **-**
 2 Brass 4 Galvanized steel 6 Concrete tile 9 ABS 12 None used (open hole)
 SCREEN OR PERFORATION OPENINGS ARE: **NA** 5 Gauzed wrapped 8 Saw cut 11 None (open hole)
 1 Continuous slot 3 Mill slot 6 Wire wrapped 9 Drilled holes
 2 Louvered shutter 4 Key punched 7 Torch cut 10 Other (specify) **-**
 SCREEN-PERFORATED INTERVALS: From **NA** ft. to **-** ft., From **-** ft. to **-** ft.
 From **-** ft. to **-** ft., From **-** ft. to **-** ft.
 GRAVEL PACK INTERVALS: From **NA** ft. to **-** ft., From **-** ft. to **-** ft.
 From **-** ft. to **-** ft., From **-** ft. to **-** ft.

6 GROUT MATERIAL: 1 Neat cement 2 Cement grout 3 Bentonite 4 Other **-**
 Grout Intervals: From **3** ft. to **9** ft., From **15** ft. to **23.3** ft., From **-** ft. to **-** ft.
 What is the nearest source of possible contamination:
 1 Septic tank 4 Lateral lines 7 Pit privy 10 Livestock pens 14 Abandoned water well
 2 Sewer lines 5 Cess pool 8 Sewage lagoon 11 Fuel storage 15 Oil well/Gas well
 3 Watertight sewer lines 6 Seepage pit 9 Feedyard 12 Fertilizer storage 16 Other (specify below)
 13 Insecticide storage **MONITORING WELLS**
 Direction from well? **E + S -** How many feet? **-**

FROM	TO	LITHOLOGIC LOG	FROM	TO	PLUGGING INTERVALS
0	3	JILTY CLAY DK			
3	13	CLAY SILT			
13	15	FINE SD-CLAYGY TAN			
15	22	CLAY SILT - SCT LEVSG SD.			
		FINE TO COARSE			
22	23.3	WEATHERED SHALE			
23.3		CARSIKLE SHALE			

7 CONTRACTOR'S OR LANDOWNER'S CERTIFICATION: This water well was (1) constructed, (2) reconstructed, or (3) plugged under my jurisdiction (and was completed on (mo/day/year) **08-17-92** and this record is true to the best of my knowledge and belief. Kansas Water Well Contractor's License No. **479** This Water Well Record was completed on (mo/day/yr) **09-19-92** under the business name of **EBBERTS DRILLING** by (signature) *Arogan Ebberts*

OFFICE USE ONLY
T
R
EW
SEC.
1/4
1/4
1/4