


1 LOCATION OF WATER WELL: County: Ness	Fraction SW 1/4 NE 1/4 SW 1/4	Section Number 31	Township Number T 18 S	Range Number R 23 E/W
---	----------------------------------	----------------------	---------------------------	--------------------------

Distance and direction from nearest town or city street address of well if located within city?
 Approximately 1/4 mile south of Ness City

2 WATER WELL OWNER: Ness City, City of
 RR#, St. Address, Box #: 109 S. Iowa
 City, State, ZIP Code: Box 419, Ness City, KS 67560
 Board of Agriculture, Division of Water Resources
 Application Number: 7126 & 236

3 LOCATE WELL'S LOCATION WITH AN "X" IN SECTION BOX:

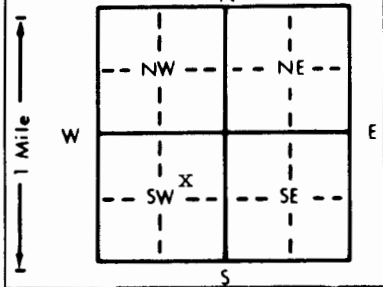

4 DEPTH OF COMPLETED WELL: 53.5 ft. ELEVATION: unknown

Depth(s) Groundwater Encountered 1. ft. 2. ft. 3. ft.
 WELL'S STATIC WATER LEVEL: 30 ft. below land surface measured on mo/day/yr 6-16-93
 Pump test data: Well water was not ch'd. ft. after hours pumping gpm
 Est. Yield unknown gpm: Well water was ft. after hours pumping gpm
 Bore Hole Diameter: 36 in. to 52.5 ft., and in. to ft.
 WELL WATER TO BE USED AS:
 5 Public water supply 8 Air conditioning 11 Injection well
 1 Domestic 3 Feedlot 6 Oil field water supply 9 Dewatering 12 Other (Specify below)
 2 Irrigation 4 Industrial 7 Lawn and garden only 10 Monitoring well
 Was a chemical/bacteriological sample submitted to Department? Yes No x; If yes, mo/day/yr sample was submitted
 Water Well Disinfected? Yes x No

5 TYPE OF BLANK CASING USED:
 1 Steel 3 RMP (SR) 5 Wrought iron 8 Concrete tile CASING JOINTS: Glued Clamped
 2 PVC 4 ABS 6 Asbestos-Cement 9 Other (specify below) Welded x
 7 Fiberglass Threaded

Blank casing diameter: 12 3/4 in. to 40 ft., Dia. 12 3/4 in. to 52.5 ft., Dia. in. to ft.
 Casing height above land surface: 12 in., weight 49.56 lbs./ft. Wall thickness or gauge No. 375

TYPE OF SCREEN OR PERFORATION MATERIAL:
 1 Steel 3 Stainless steel 5 Fiberglass 7 PVC 10 Asbestos-cement
 2 Brass 4 Galvanized steel 6 Concrete tile 8 RMP (SR) 11 Other (specify)
 9 ABS 12 None used (open hole)

SCREEN OR PERFORATION OPENINGS ARE:
 1 Continuous slot 3 Mill slot 5 Gauzed wrapped 8 Saw cut 11 None (open hole)
 2 Louvered shutter 4 Key punched 6 Wire wrapped 9 Drilled holes
 7 Torch cut 10 Other (specify)

SCREEN-PERFORATED INTERVALS: From 40 ft. to 49 ft., From ft. to ft.
 GRAVEL PACK INTERVALS: From 0 ft. to 40 ft., From ft. to ft.
 From 49 ft. to 52.5 ft., From ft. to ft.

6 GROUT MATERIAL: Topsoil Neat cement 2 Cement grout 3 Bentonite 4 Other Bentonite Holeplug
 Grout Intervals: From 0 ft. to 7 ft., From 7 ft. to 28 ft., From 28 ft. to 31 ft.

What is the nearest source of possible contamination:
 1 Septic tank 4 Lateral lines 7 Pit privy 10 Livestock pens 14 Abandoned water well
 2 Sewer lines 5 Cess pool 8 Sewage lagoon 11 Fuel storage 15 Oil well/Gas well
 3 Watertight sewer lines 6 Seepage pit 9 Feedyard 12 Fertilizer storage 16 Other (specify below)
 13 Insecticide storage None known

Direction from well? How many feet?

FROM	TO	LITHOLOGIC LOG	FROM	TO	PLUGGING INTERVALS
0	4	Topsoil			
4	24	Clay, brown			
24	33	Sand, streaks of clay, gray			
33	35	Clay, gray			
35	39	Sand and gravel, fine, streaks of clay			
39	44	Sand and gravel, streaks of clay and wood chips			
44	49	Sand and gravel, fine			
49	52.5	Shale, black			

7 CONTRACTOR'S OR LANDOWNER'S CERTIFICATION: This water well was (1) constructed, (2) reconstructed, or (3) plugged under my jurisdiction and was completed on (mo/day/year) 6-16-93 and this record is true to the best of my knowledge and belief. Kansas Water Well Contractor's License No. 185 This Water Well Record was completed on (mo/day/yr) 7-26-93 under the business name of Clarke Well & Equipment, Inc. by (signature)

OFFICE USE ONLY
T
R
EW
SEC.
1/4
1/4
1/4