

USE TYPEWRITER OR BALL POINT PEN—PRESS FIRMLY, PRINT CLEARLY.

WATER WELL RECORD
KSA 82a-1201-1215

BAA


miss city

T R EW sec 1/4 1/4 1/4 No.

Kansas State Dept. Of Health
(Water Well Contractors)
Forbes-Bldg. 740
Topeka, Kansas 66620

1 Location of well:	County NESS	Township name CENTER	Fraction NE NE NW	Section number 31	Town number 18S	Range number 23W
---------------------	-----------------------	--------------------------------	-----------------------------	-----------------------------	---------------------------	----------------------------

Distance and direction from nearest town or city: **InTown**
 Street address of well location if in city: **803 S Court Ave**
 3 Owner of well: **Bill Stiawalt**
 Address: **Ness City, Ks. 67560**

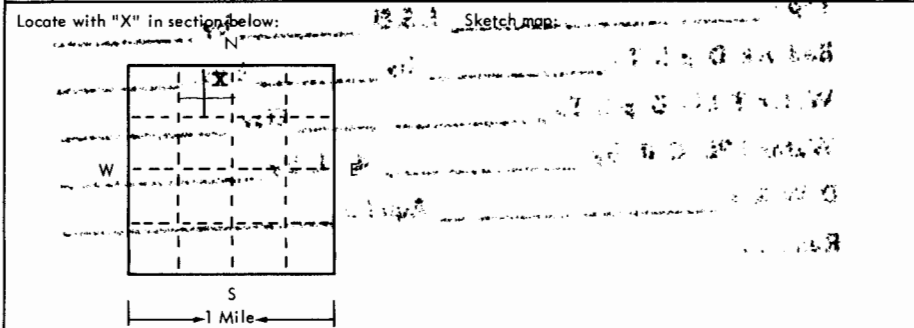

4 Well depth: **80** ft. Date of completion **5-25-75**
 Well diameter **7 3/4** in.

5 Cable tool Rotary Driven Dug
 Hollow rod Jetted Bored Reverse rotary

6 Use: Domestic Public supply Industry
 Irrigation Air conditioning Commercial
 Test well

7 Casing: Material **Plastic**: above/below
 Threaded Welded Surface **5** in.
 Diam. **5** (Cemented) Weight **250** lbs./ft.
0 in. to **80** ft. depth! Drive shoe? Yes No

2	Type and color of material	From	To
	Clay	0	20
	Clay	20	40
	Streaks of sand	40	60
	Sand	60	70
	Shale	70	80
	Rock 70' - 1/2 in		
	54		
	16' sat thick		
	Alluvium		

8 Screen: **Dealer:**
 Manufacturer **W A Brown Enterprises**
 Type **Plastic** Dia. **5**
 Slot/gauze **1/16x1 1/8**
 Set between **60** ft. and **80** ft.
 Fittings: **1/4 1/16**
 Gravel pack Yes No Size range of material **1/4**

9 Static water level:
54 ft. below land surface Date **5-25-75**

10 Pumping level below land surfaces:
 _____ ft. after _____ hrs. pumping _____ g.p.m.
 _____ ft. after _____ hrs. pumping _____ g.p.m.
 Estimated maximum yield **14** g.p.m.

11 Water sample submitted:
 Yes No Date _____

12 Well head completion:
 Pitless adapter Inches above grade

13 Well grouted? Yes No
 Neat cement Bentonite _____
 Depth: From **4** ft. to **8** ft.

14 Nearest source of possible contamination: **Katruha**
 ft. **70** Direction **South** Type _____
 Well disinfected upon completion? Yes No

15 Pump: Not installed
 Manufacturer's name _____
 Model number _____ HP _____ Volts _____
 Length of drop pipe _____ ft. capacity _____ g.m.p.
 Type:
 Submersible Turbine
 Jet Reciprocating
 Centrifugal Other

16 Remarks: elevation
 Topography:
 Hill
 Slope
 Upland **Level**
 Valley
2252
2182

17 Water well contractor's certification:
 This well was drilled under my jurisdiction and this report is true to the best of my knowledge and belief.
High Plains Drilling & Supply, Inc
 Business name License No. _____
 Address **102 N 3rd Garden City, Ks**
 Signed **Blady G. Starbom** Date **6-18-75**
 Authorized Representative