


1 LOCATION OF WATER WELL: Fraction C-NE 1/4 SE 1/4 SW 1/4 Section Number 30 Township Number T 18 S Range Number R 23 E/W
 County: NESS

Distance and direction from nearest town or city street address of well if located within city?
C-1/2 BLCK - S 1/2 MAIN - N OF SYCAMORE - W IF COURT NESS CITY

2 WATER WELL OWNER: HAROLD GABEL
 RR#, St. Address, Box # 301 W SYCAMORE NESS CITY KS. 67520 Board of Agriculture, Division of Water Resources
 City, State, ZIP Code Application Number:

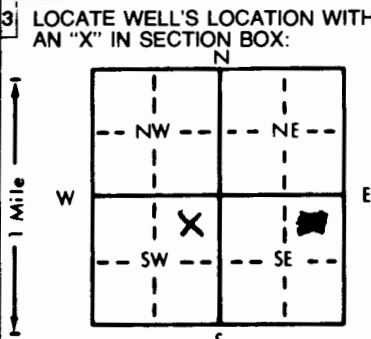

4 DEPTH OF COMPLETED WELL: 52 ft. ELEVATION: 2255.3
 Depth(s) Groundwater Encountered 1. 48.8 ft. 2. - ft. 3. - ft.
 WELL'S STATIC WATER LEVEL 45.42 ft. below land surface measured on mo/day/yr 08-26-92
 NA Pump test data: Well water was - ft. after - hours pumping - gpm
 Est. Yield UNKNOWN gpm: Well water was - ft. after - hours pumping - gpm
 Bore Hole Diameter: 7.25 in. to 52 ft. and - in. to - ft.
 WELL WATER TO BE USED AS:
 5 Public water supply 8 Air conditioning 11 Injection well
 1 Domestic 3 Feedlot 6 Oil field water supply 9 Dewatering 12 Other (Specify below)
 2 Irrigation 4 Industrial 7 Lawn and garden only 10 Monitoring well
 Was a chemical/bacteriological sample submitted to Department? Yes - No X; If yes, mo/day/yr sample was submitted
 Water Well Disinfected? Yes - No X

5 TYPE OF BLANK CASING USED:
 1 Steel 3 RMP (SR) 5 Wrought iron 8 Concrete tile CASING JOINTS: Glued - Clamped -
 2 PVC 4 ABS 6 Asbestos-Cement 9 Other (specify below) Welded -
 7 Fiberglass Threaded X
 Blank casing diameter 2 in. to 32 ft., Dia 2" SCREEN to 52 ft., Dia - in. to - ft.
 Casing height above land surface 1.8 in., weight SCH 40 lbs./ft. Wall thickness or gauge No. -
 TYPE OF SCREEN OR PERFORATION MATERIAL:
 1 Steel 3 Stainless steel 5 Fiberglass 8 RMP (SR) 10 Asbestos-cement
 2 Brass 4 Galvanized steel 6 Concrete tile 9 ABS 11 Other (specify) -
 12 None used (open hole)
 SCREEN OR PERFORATION OPENINGS ARE:
 1 Continuous slot 3 Mill slot 5 Gauzed wrapped 8 Saw cut 11 None (open hole)
 2 Louvered shutter 4 Key punched 6 Wire wrapped 9 Drilled holes
 7 Torch cut 10 Other (specify) -
 SCREEN-PERFORATED INTERVALS: From 32 ft. to 52 ft., From - ft. to - ft.
 From - ft. to - ft., From - ft. to - ft.
 GRAVEL PACK INTERVALS: From 3.1 ft. to 52 ft., From - ft. to - ft.
 From - ft. to - ft., From - ft. to - ft.

6 GROUT MATERIAL: 1 Neat cement 2 Cement grout 3 Bentonite 4 Other -
 Grout Intervals: From 1.5 ft. to 3.1 ft., From - ft. to - ft., From - ft. to - ft.
 What is the nearest source of possible contamination:
 1 Septic tank 4 Lateral lines 7 Pit privy 10 Livestock pens 14 Abandoned water well
 2 Sewer lines 5 Cess pool 8 Sewage lagoon 11 Fuel storage 15 Oil well/Gas well
 3 Watertight sewer lines 6 Seepage pit 9 Feedyard 12 Fertilizer storage 16 Other (specify below)
 13 Insecticide storage
 Direction from well? N How many feet? 0

FROM	TO	LITHOLOGIC LOG	FROM	TO	PLUGGING INTERVALS
0	2.4	FILL MATERIAL			
2.4	6.4	SILTY CLAY			
6.4	31.8	CLAY SILT-TAN - SD LENSE - SCT. GRAVEL			
31.8	42	SAND - CO. - FINE LENSE SCT. GRAVEL			
42	44	SILTY CLAY - GREEN - GREY			
44	47	SILTY CLAY - LT. GREY			
47	48.8	SILTY CLAY - GREEN - GREY			
48.8	52	SAND - COARSE			
52		SHALE - DARK GREY			

7 CONTRACTOR'S OR LANDOWNER'S CERTIFICATION: This water well was (1) constructed, (2) reconstructed, or (3) plugged under my jurisdiction and was completed on (mo/day/year) 08-25-92 and this record is true to the best of my knowledge and belief. Kansas Water Well Contractor's License No. 479 This Water Well Record was completed on (mo/day/yr) 09-10-92 under the business name of EBBERTS DRILLING by (signature) August Ebberts

OFFICE USE ONLY
T
R
EW
SEC.
1/4
1/4
1/4