

**WATER WELL PLUGGING RECORD Form WWC-5P**

KSA 82a-1212

ID NO.

MW1

<b>1 LOCATION OF WATER WELL:</b> County: <b>NESS</b>	Fraction <b>SE ¼ NW¼ SW ¼ SE ¼</b>	Section Number <b>30</b>	Township Number <b>T 18 S</b>	Range Number <b>23</b> <input type="checkbox"/> E <input checked="" type="checkbox"/> W
---	---------------------------------------	-----------------------------	----------------------------------	--

Street/Rural Address of Well Location; if unknown, distance & direction from nearest town or intersection: If at owner's address, check here

**Global Positioning Systems (GPS) information:**  
 Latitude: 38.45304 (in decimal degrees)  
 Longitude: 99.90616 (in decimal degrees)  
 Elevation: 2252.35  
 Horizontal Datum:  WGS84,  NAD83,  NAD27  
 Collection Method:

**2 WATER WELL OWNER:** **E. JAY DEINES**  
 RR#, St. Address, Box #: **120 WEST SYCAMORE ST**  
 City, State ZIP Code: **NESS CITY, KS 67560**

GPS unit (Make/Model: \_\_\_\_\_)  
 Digital Map/Photo,  Topographic Map,  Land Survey  
 Est. Accuracy:  < 3 m,  3-5 m,  5-15 m,  > 15 m

**3 MARK WELL'S LOCATION WITH AN "X" IN SECTION BOX:**

**4 DEPTH OF WELL** 47.79 ft.  
 WELL'S STATIC WATER LEVEL 28.81 ft  
 WELL WAS USED AS:  
 Domestic  Public Water Supply  Dewatering  
 Irrigation  Oil Field Water Supply  Monitoring  
 Feedlot  Domestic (Lawn & Garden)  Injection Well  
 Industrial  Air Conditioning  Other \_\_\_\_\_  
 Was a chemical/bacteriological sample submitted to Department? Yes  No

**5 TYPE OF BLANK CASING USED:**

Steel  RMP (SR)  Wrought  Fiberglass  Other (Specify below) \_\_\_\_\_  
 PVC  ABS  Asbestos-Cement  Concrete Tile

Blank casing diameter 2<sup>BA</sup> in. Was casing pulled? Yes  No  If yes, how much 3'  
 Casing height above or below land surface 36 in.

**6 GROUT PLUG MATERIAL:**  Neat cement  Cement grout  Bentonite  Other CONCRETE 0-0.5

Grout Plug Intervals: From 0.5 ft. to 47.79 ft., From \_\_\_\_\_ ft. to \_\_\_\_\_ ft., From \_\_\_\_\_ ft. to \_\_\_\_\_ ft.



What is the nearest source of possible contamination:  
 Septic tank  Seepage pit  Fuel storage  Other (specify below) \_\_\_\_\_  
 Sewer lines  Pit privy  Fertilizer storage \_\_\_\_\_  
 Watertight sewer lines  Sewage lagoon  Insecticide storage \_\_\_\_\_  
 Lateral lines  Feedyard  Abandoned water well Direction from well? \_\_\_\_\_  
 Cess pool  Livestock pens  Oil well/Gas well How many feet? \_\_\_\_\_

FROM	TO	PLUGGING MATERIALS	FROM	TO	PLUGGING MATERIALS
0	0.5	CONCRETE			
0.5	47.49	BENTONITE			

**7 CONTRACTOR'S OR LANDOWNER'S CERTIFICATION:** This water well was plugged under my jurisdiction and was completed on (mo/day/year) 9/7/23 and this record is true to the best of my knowledge and belief. Kansas Water Well Contractor's License No. 585. This Water Well Record was completed on (mo/day/year) 10/3/23 under the business name of ASSOCIATED ENVIRONMENTAL INC. by (signature) \_\_\_\_\_

Send one white copy to Kansas Department of Health & Environment, Geology Section, 1000 SW Jackson Street, Ste. 420, Topeka, KS 66612-1367. Send one copy to WATER WELL OWNER and retain one for your records.  
 Visit us at <http://www.kdheks.gov/waterwell/index.html> Telephone 785-296-5524.

KSA82a-1212 Revised 1/20/2015

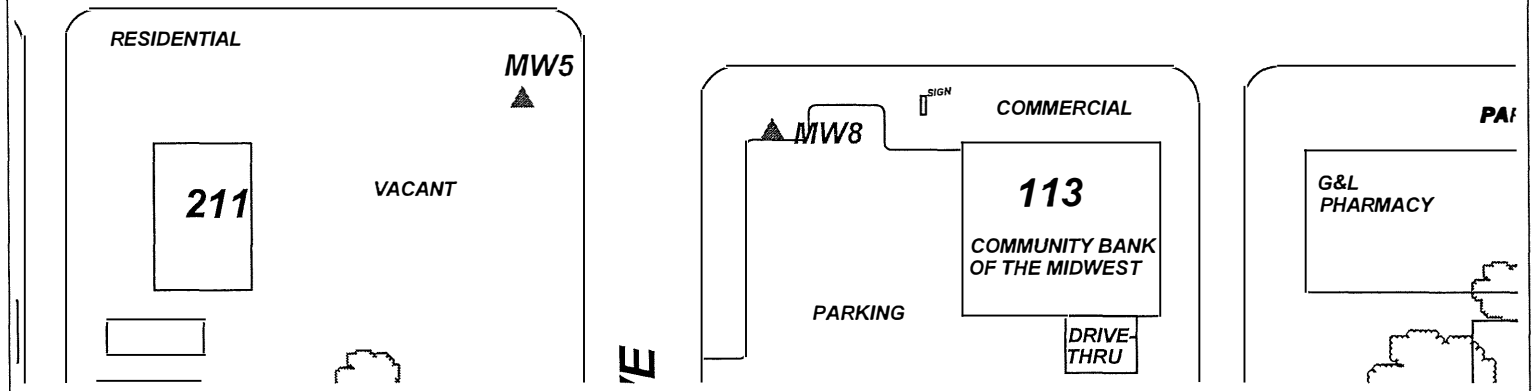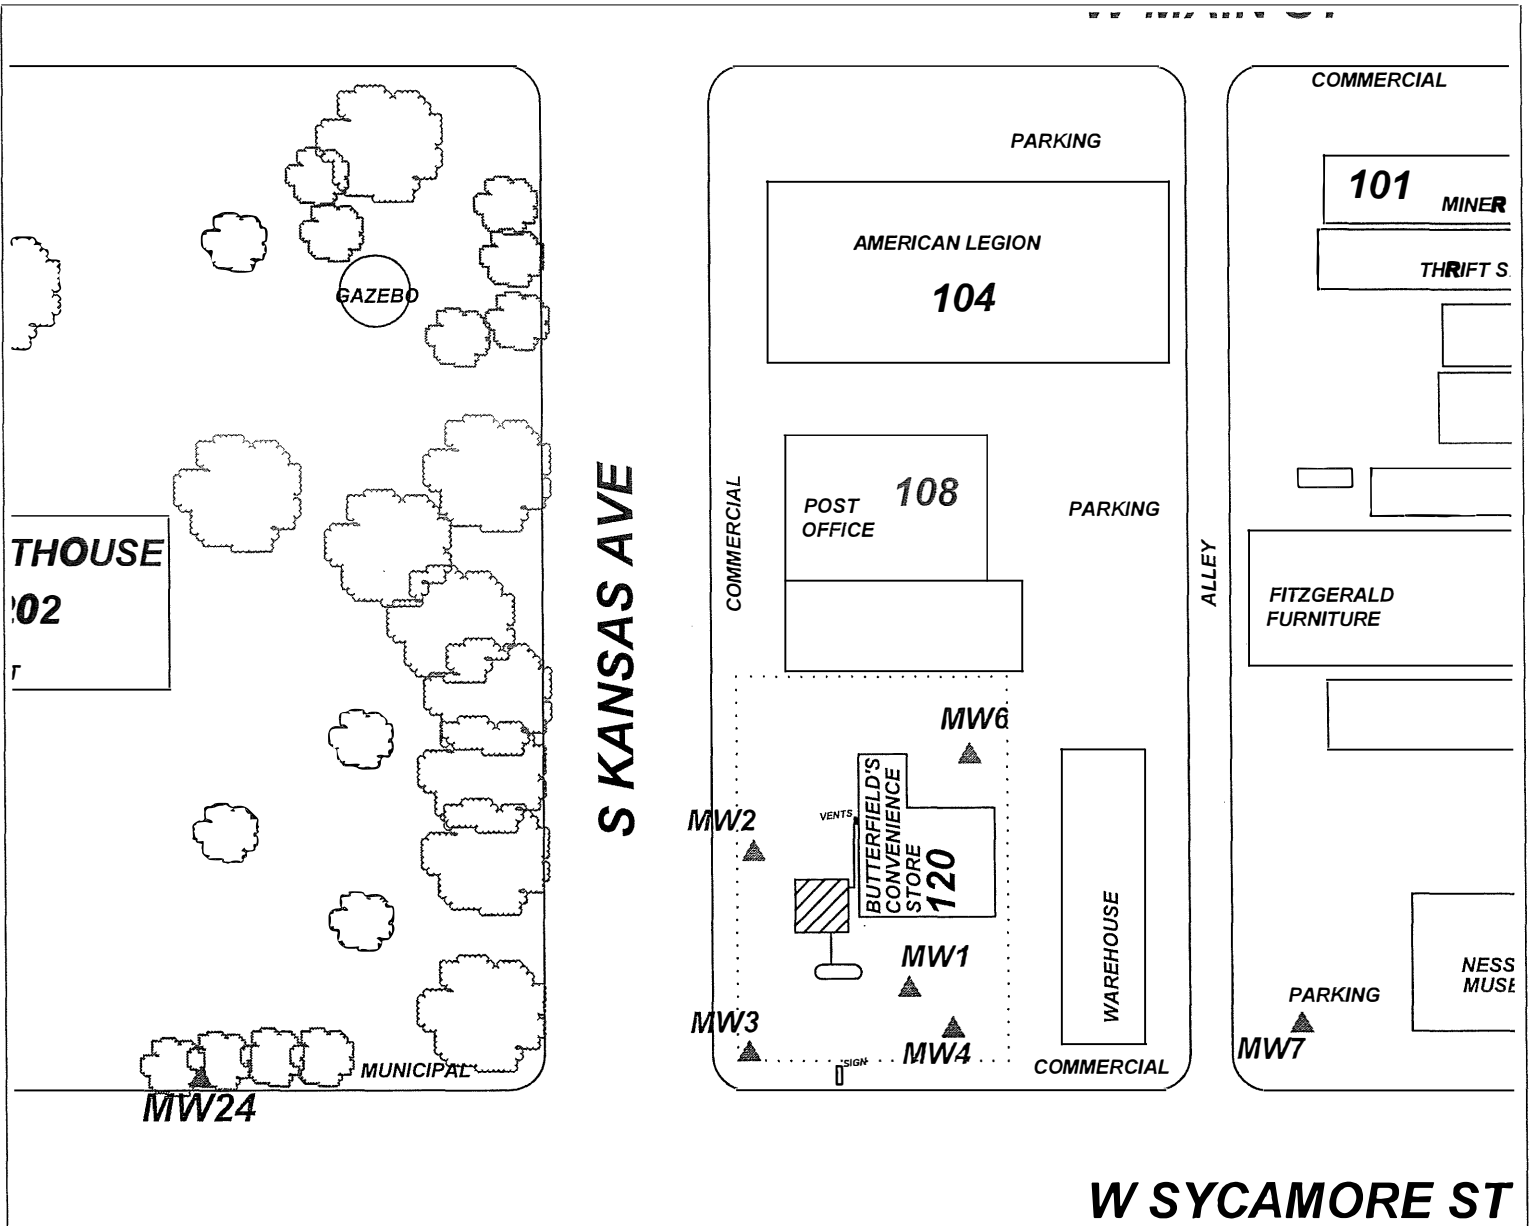


PROJECT: BUTTERFIELD, INC.  
 ADDRESS: 120 WEST SYCAMORE STREET  
 LOCATION: NESS CITY, KANSAS  
 DRAWN BY: B. JOHNSON DATE: 1/9/19  
 REVISED BY: B. STALNAKER DATE: 10/3/23  
 AEI JOB #: TF516 KOHE JOB #: U6-068-15094

TITLE:

**ASSOCIATED ENVIRONMENTAL INC.**

LEGEND:  
 = CURRENT UST BASIN; 2-6,000 GAL. GAS, PRODUCT LINES AND PUMP ISLAND  
 = MONITORING WELL  
 = PLUGGED/DESTROYED WELL  
 ..... = SUBJECT PROPERTY

T. 18 R. 23W Sec. 30  
 Ness County

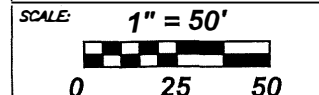

NOTES: