

WATER WELL PLUGGING RECORD Form WWC-5P KSA 82a-1212 ID NO.

MW5

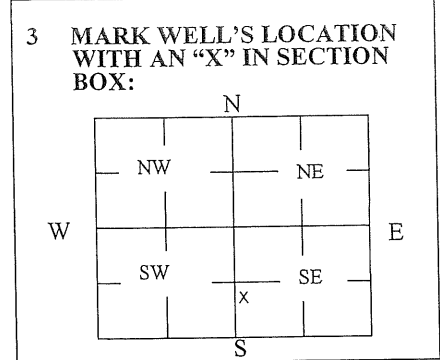
1 LOCATION OF WATER WELL: Fraction SE 1/4 NW 1/4 SW 1/4 SE 1/4 Section Number 30 Township Number T 18 S Range Number 23 E W
 County: NESS

Street/Rural Address of Well Location; if unknown, distance & direction from nearest town or intersection: If at owner's address, check here

Global Positioning Systems (GPS) information:
 Latitude: 38.45268 (in decimal degrees)
 Longitude: 99.90655 (in decimal degrees)
 Elevation: 2251.12
 Horizontal Datum: WGS84, NAD83, NAD27
 Collection Method:

2 WATER WELL OWNER: E. JAY DEINES
 RR#, St. Address, Box #: 120 WEST SYCAMORE ST
 City, State ZIP Code: NESS CITY, KS 67560

GPS unit (Make/Model: _____)
 Digital Map/Photo, Topographic Map, Land Survey
 Est. Accuracy: < 3 m, 3-5 m, 5-15 m, > 15 m



4 DEPTH OF WELL 40.08 ft.
 WELL'S STATIC WATER LEVEL 27.79 ft.
 WELL WAS USED AS:
 Domestic Public Water Supply Dewatering
 Irrigation Oil Field Water Supply Monitoring
 Feedlot Domestic (Lawn & Garden) Injection Well
 Industrial Air Conditioning Other _____

Was a chemical/bacteriological sample submitted to Department? Yes No

5 TYPE OF BLANK CASING USED:

Steel RMP (SR) Wrought Fiberglass Other (Specify below) _____
 PVC ABS Asbestos-Cement Concrete Tile

Blank casing diameter 2 BA in. Was casing pulled? Yes No If yes, how much 3'
 Casing height above or below land surface 36 in.

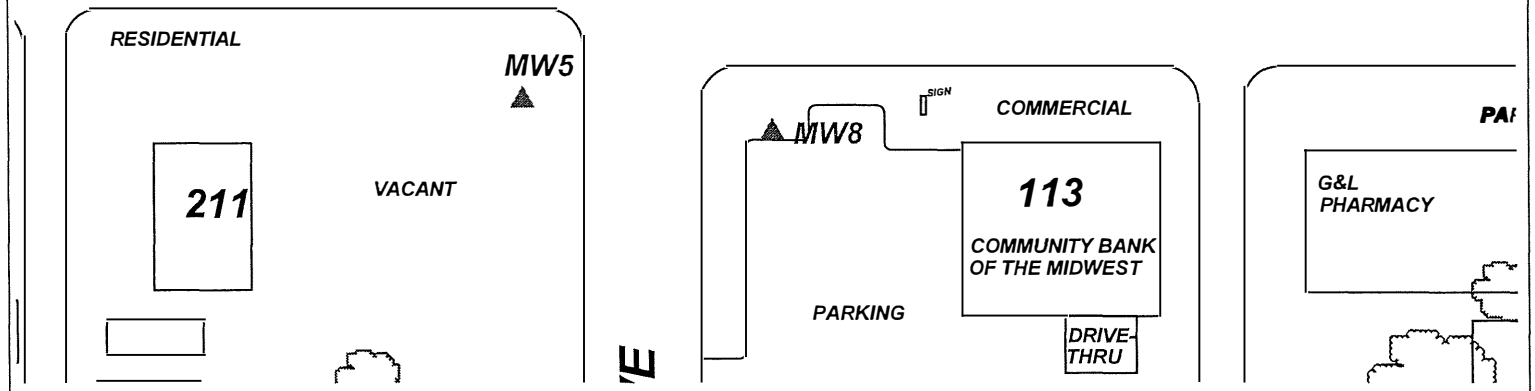
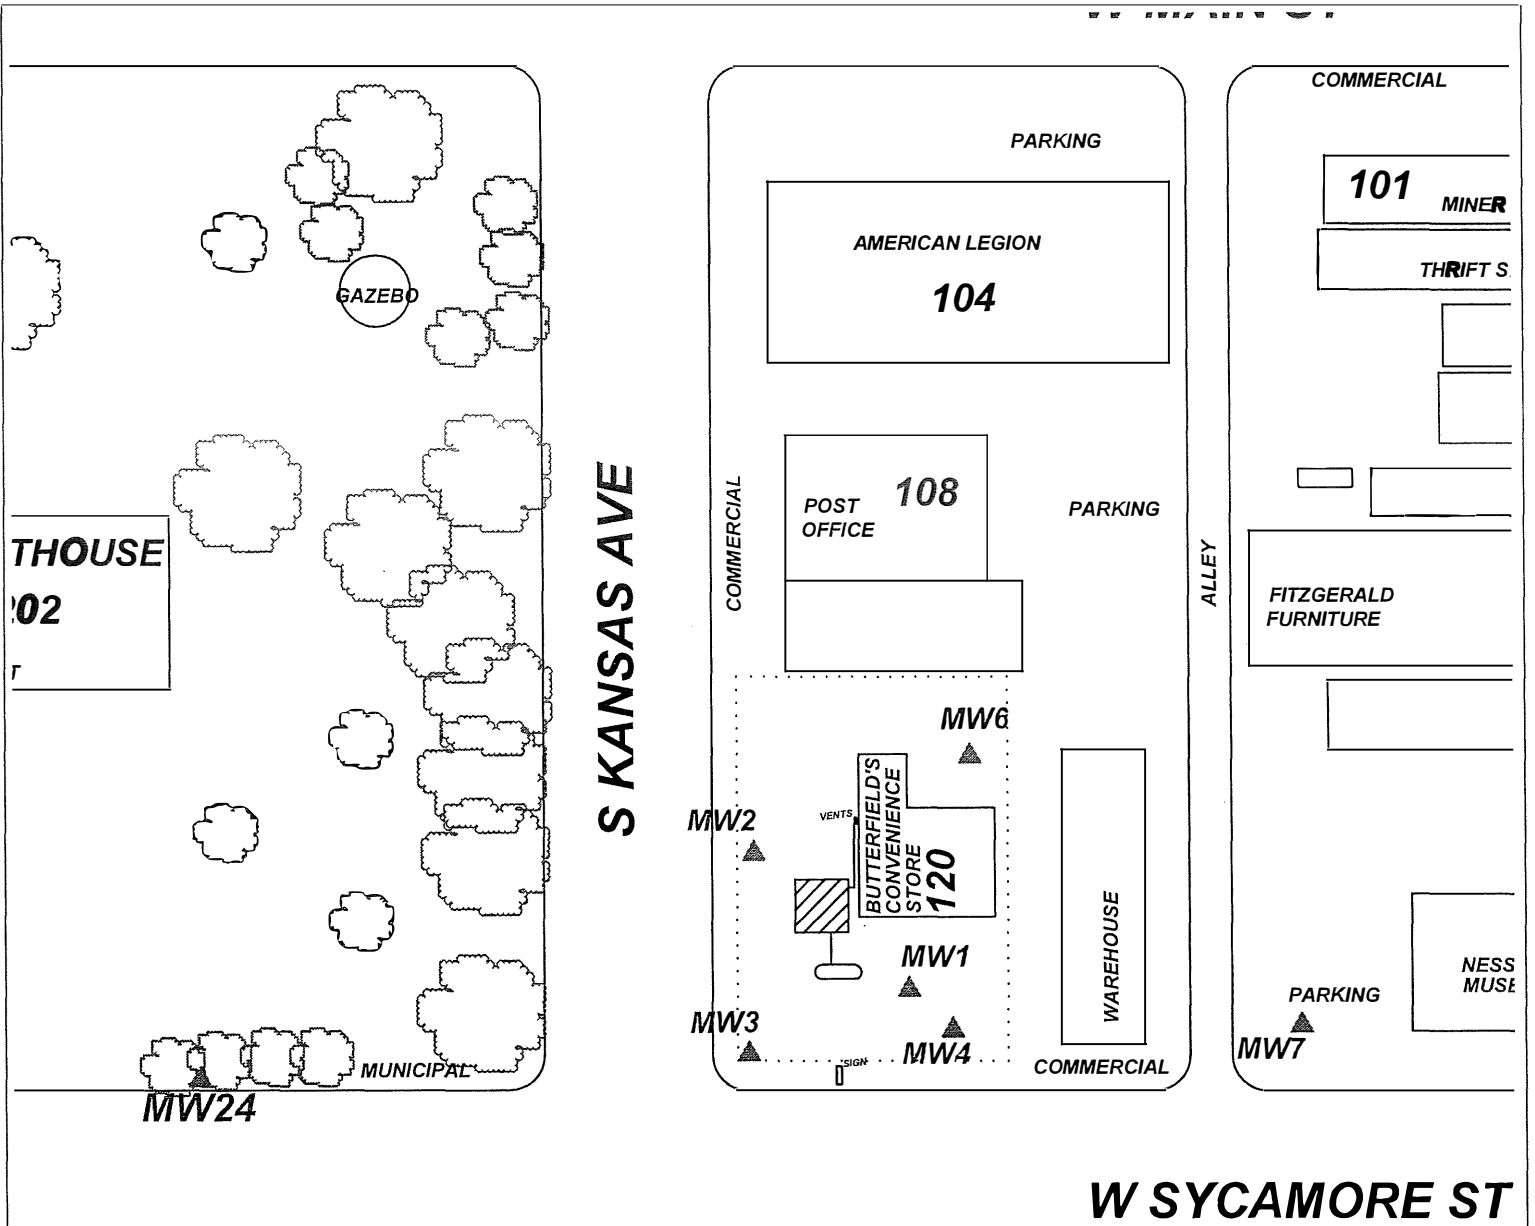
6 GROUT PLUG MATERIAL: Neat cement Cement grout Bentonite Other TOPSOIL 0-0.5

Grout Plug Intervals: From 0.5 ft. to 40.08 ft., From _____ ft. to _____ ft., From _____ ft. to _____ ft.

What is the nearest source of possible contamination:
 Septic tank Seepage pit Fuel storage Other (specify below) _____
 Sewer lines Pit privy Fertilizer storage _____
 Watertight sewer lines Sewage lagoon Insecticide storage _____
 Lateral lines Feedyard Abandoned water well Direction from well? _____
 Cess pool Livestock pens Oil well/Gas well How many feet? _____




FROM	TO	PLUGGING MATERIALS	FROM	TO	PLUGGING MATERIALS
0	0.5	TOPSOIL			
0.5	40.08	BENTONITE			


7 CONTRACTOR'S OR LANDOWNER'S CERTIFICATION: This water well was plugged under my jurisdiction and was completed on (mo/day/year) 9/7/23 and this record is true to the best of my knowledge and belief. Kansas Water Well Contractor's License No. 585. This Water Well Record was completed on (mo/day/year) 10/3/23 under the business name of ASSOCIATED ENVIRONMENTAL INC. by (signature) _____



PROJECT: BUTTERFIELD, INC.
 ADDRESS: 120 WEST SYCAMORE STREET
 LOCATION: NESS CITY, KANSAS
 DRAWN BY: B. JOHNSON DATE: 1/9/19
 REVISED BY: B. STALNAKER DATE: 10/3/23
 AEI JOB #: TF516 KOHE JOB #: U6-068-15094

TITLE:
 ASSOCIATED ENVIRONMENTAL INC.

LEGEND:
 = CURRENT UST BASIN; 2-6,000 GAL. GAS, PRODUCT LINES AND PUMP ISLAND
 = MONITORING WELL
 = PLUGGED/DESTROYED WELL
 = SUBJECT PROPERTY
 T. 18 R. 23W Sec. 30
 Ness County

SCALE: 1" = 50'


NOTES: