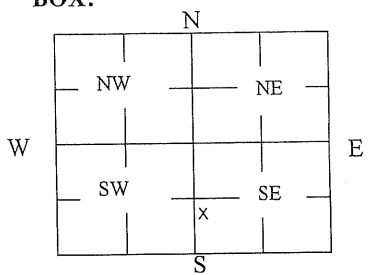


WATER WELL PLUGGING RECORD Form WWC-5P KSA 82a-1212 ID NO.

MW8

1 LOCATION OF WATER WELL: County: NESS	Fraction SE ¼ NW¼ SW ¼ SE ¼	Section Number 30	Township Number T 18 S	Range Number 23 <input type="checkbox"/> E <input checked="" type="checkbox"/> W
Street/Rural Address of Well Location; if unknown, distance & direction from nearest town or intersection: If at owner's address, check here <input type="checkbox"/> 113 W. SYCAMORE ST. NESS CITY, KS 67560		Global Positioning Systems (GPS) information: Latitude: 38.45268 (in decimal degrees) Longitude: 99.90633 (in decimal degrees) Elevation: 2251.48 Horizontal Datum: <input type="checkbox"/> WGS84, <input checked="" type="checkbox"/> NAD83, <input type="checkbox"/> NAD27 Collection Method: <input type="checkbox"/> GPS unit (Make/Model: _____) <input type="checkbox"/> Digital Map/Photo, <input type="checkbox"/> Topographic Map, <input checked="" type="checkbox"/> Land Survey Est. Accuracy: <input checked="" type="checkbox"/> < 3 m, <input type="checkbox"/> 3-5 m, <input type="checkbox"/> 5-15 m, <input type="checkbox"/> > 15 m		
2 WATER WELL OWNER: E. JAY DEINES RR#, St. Address, Box #: 120 WEST SYCAMORE ST City, State ZIP Code: NESS CITY, KS 67560				

3 MARK WELL'S LOCATION WITH AN "X" IN SECTION BOX: 	4 DEPTH OF WELL <u>32.10</u> ft. WELL'S STATIC WATER LEVEL <u>28.08</u> ft WELL WAS USED AS: <input type="checkbox"/> Domestic <input type="checkbox"/> Public Water Supply <input checked="" type="checkbox"/> Dewatering <input type="checkbox"/> Irrigation <input type="checkbox"/> Oil Field Water Supply <input type="checkbox"/> Monitoring <input type="checkbox"/> Feedlot <input type="checkbox"/> Domestic (Lawn & Garden) <input type="checkbox"/> Injection Well <input type="checkbox"/> Industrial <input type="checkbox"/> Air Conditioning <input type="checkbox"/> Other _____ Was a chemical/bacteriological sample submitted to Department? Yes <input type="checkbox"/> No <input checked="" type="checkbox"/>
--	---

5 TYPE OF BLANK CASING USED:

Steel RMP (SR) Wrought Fiberglass Other (Specify below) _____
 PVC ABS Asbestos-Cement Concrete Tile _____


Blank casing diameter 2^{BA} in. Was casing pulled? Yes No If yes, how much 3'
 Casing height above or below land surface 36 in.



6 GROUT PLUG MATERIAL: Neat cement Cement grout Bentonite Other TOPSOIL 0-0.5

Grout Plug Intervals: From 0.5 ft. to 32.10 ft., From _____ ft. to _____ ft., From _____ ft. to _____ ft.

What is the nearest source of possible contamination:
 Septic tank Seepage pit Fuel storage Other (specify below) _____
 Sewer lines Pit privy Fertilizer storage _____
 Watertight sewer lines Sewage lagoon Insecticide storage _____
 Lateral lines Feedyard Abandoned water well Direction from well? _____
 Cess pool Livestock pens Oil well/Gas well How many feet? _____



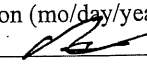

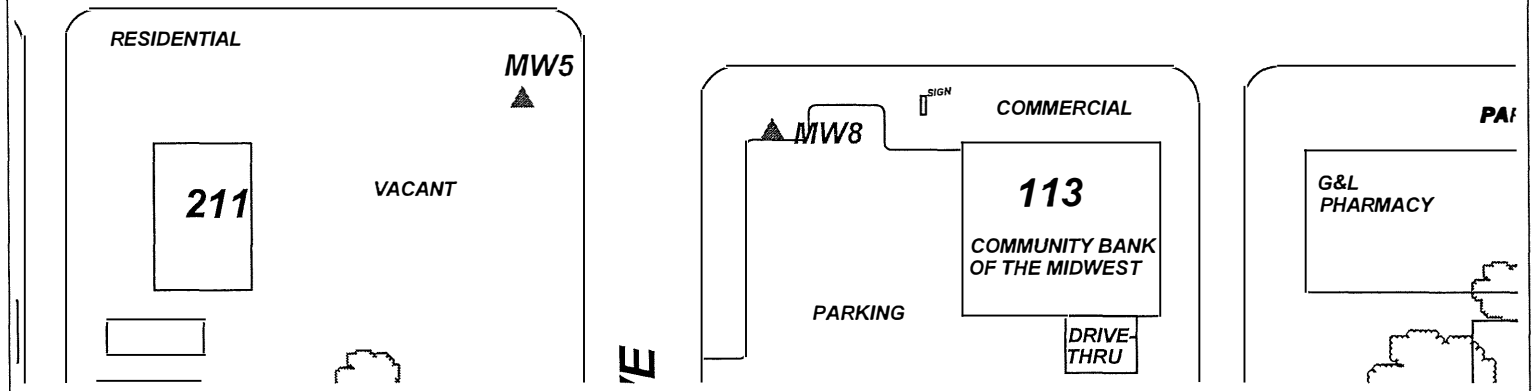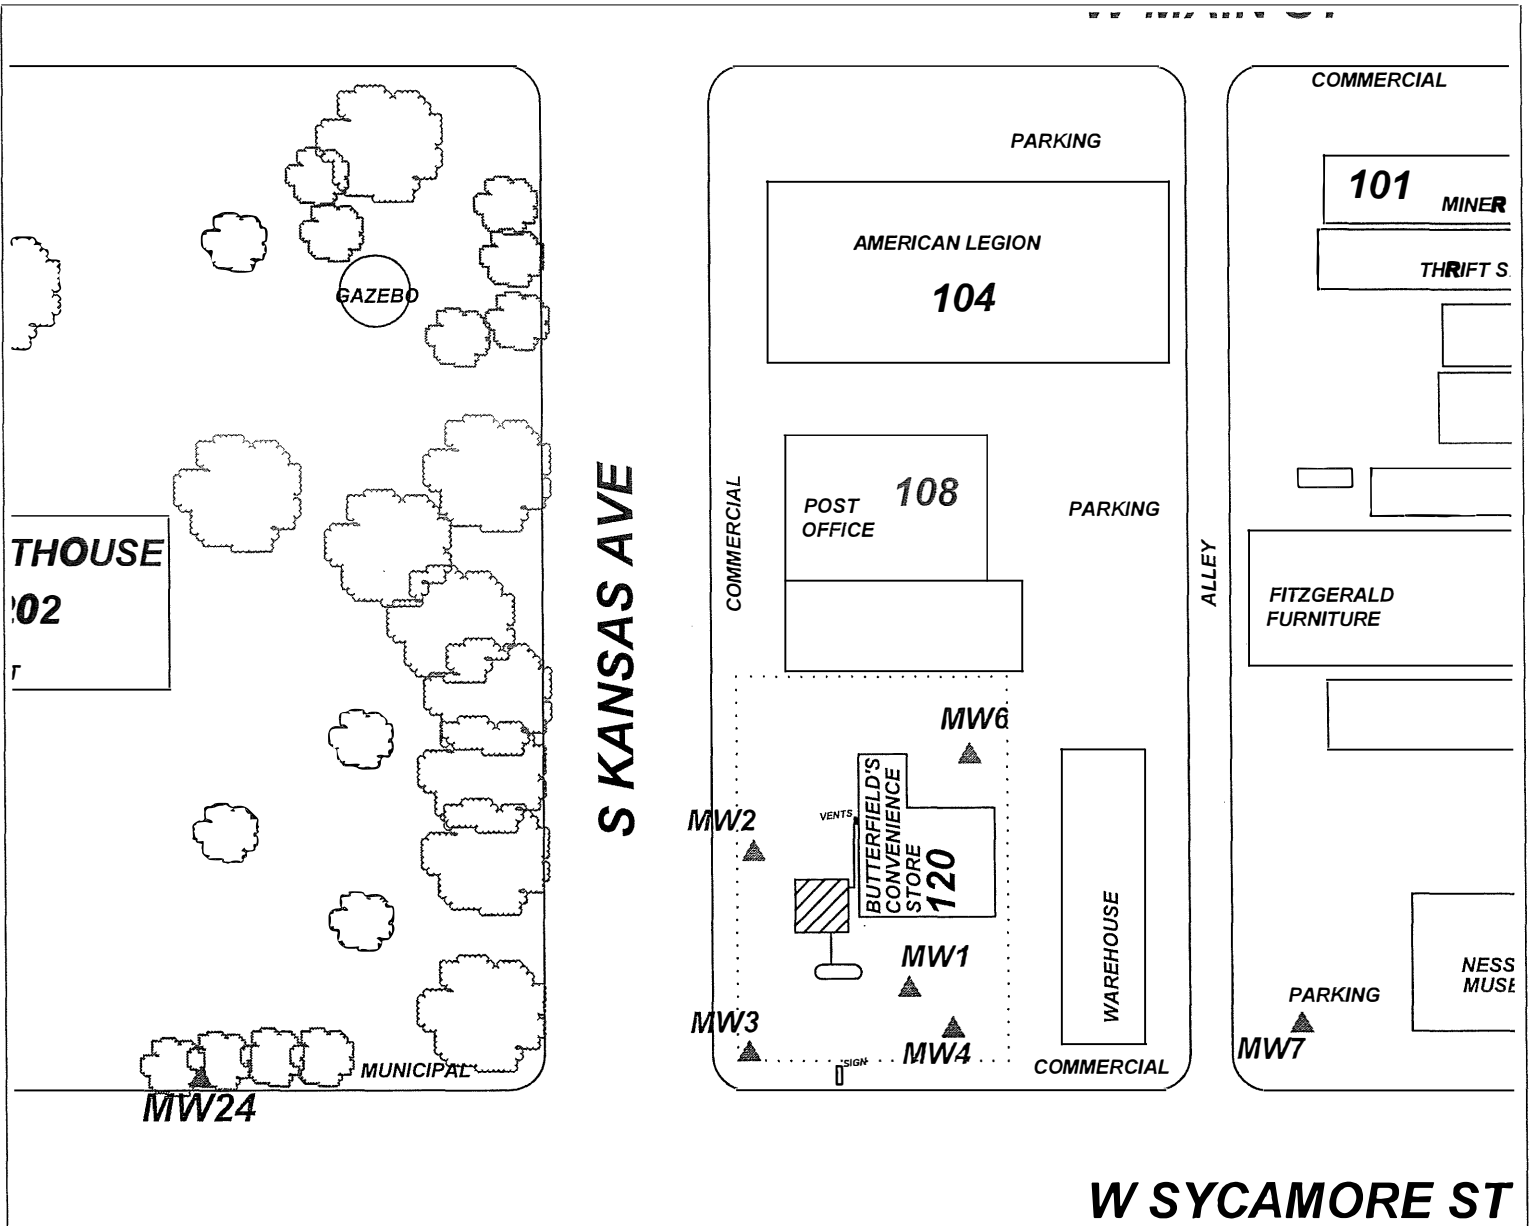FROM	TO	PLUGGING MATERIALS	FROM	TO	PLUGGING MATERIALS
0	0.5	TOPSOIL			
0.5	32.10	BENTONITE			


7 CONTRACTOR'S OR LANDOWNER'S CERTIFICATION: This water well was plugged under my jurisdiction and was completed on (mo/day/year) 9/7/23 and this record is true to the best of my knowledge and belief. Kansas Water Well Contractor's License No. 585. This Water Well Record was completed on (mo/day/year) 10/3/23 under the business name of ASSOCIATED ENVIRONMENTAL INC. by (signature) 



PROJECT: BUTTERFIELD, INC.
 ADDRESS: 120 WEST SYCAMORE STREET
 LOCATION: NESS CITY, KANSAS
 DRAWN BY: B. JOHNSON DATE: 1/9/19
 REVISED BY: B. STALNAKER DATE: 10/3/23
 AEI JOB #: TF516 KOHE JOB #: U6-068-15094

TITLE:
 ASSOCIATED ENVIRONMENTAL INC.

LEGEND:
 = CURRENT UST BASIN; 2-6,000 GAL. GAS, PRODUCT LINES AND PUMP ISLAND
 = MONITORING WELL
 = PLUGGED/DESTROYED WELL

 = SUBJECT PROPERTY
 T. 18 R. 23W Sec. 30
 Ness County

SCALE: 1" = 50'


NOTES: