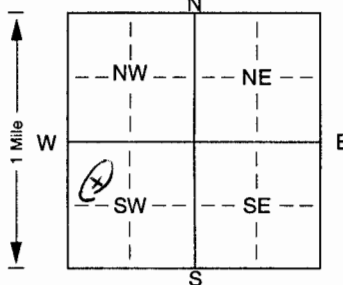


1 LOCATION OF WATER WELL: Fraction SW 1/4 NW 1/4 SW 1/4 Section Number 34 Township Number T 18 S R 25 Range Number EW
 County: MIAMI
 Distance and direction from nearest town or city street address of well if located within city?
4695 W. 375th Louisburg, Kansas 66053

2 WATER WELL OWNER: Randy Pickert
 RR#, St. Address, Box # : 8822 Eby Street Board of Agriculture, Division of Water Resources
 City, State, ZIP Code : Overland Park, Kansas 66212 Application Number:

3 LOCATE WELL'S LOCATION WITH AN "X" IN SECTION BOX:

 4 DEPTH OF COMPLETED WELL: 250 ft. ELEVATION:
 Depth(s) Groundwater Encountered 1. 180 ft. 2. 237 ft. 3. ft.
 WELL'S STATIC WATER LEVEL: 100 ft. below land surface measured on mo/day/yr 4/16/05
 Pump test data: Well water was ft. after hours pumping gpm
 Est. Yield \pm 2 gpm: Well water was ft. after hours pumping gpm
 Bore Hole Diameter: 10 in. to 250 ft., and in. to ft.
 WELL WATER TO BE USED AS:
 1 Domestic 3 Feedlot 6 Oil field water supply 9 Dewatering 12 Other (Specify below)
 2 Irrigation 4 Industrial 7 Domestic (lawn & garden) 10 Monitoring well
 Was a chemical/bacteriological sample submitted to Department? Yes. No. ; If yes, mo/day/yr sample was sub-
 mitted Water Well Disinfected? Yes No

5 TYPE OF BLANK CASING USED:
 1 Steel 3 RMP (SR) 6 Asbestos-Cement 9 Other (specify below) CASING JOINTS: Glued Clamped
 2 PVC 4 ABS 7 Fiberglass Welded
 Threaded
 Blank casing diameter 5 in. to 160 ft., Dia. 5 in. to 230 ft., Dia. 5 in. to 250 ft.
 Casing height above land surface: 18 in., weight SDR 21 lbs./ft. Wall thickness or gauge No. 200 PSI
 TYPE OF SCREEN OR PERFORATION MATERIAL:
 1 Steel 3 Stainless steel 5 Fiberglass 7 PVC 10 Asbestos-cement
 2 Brass 4 Galvanized steel 6 Concrete tile 8 RMP (SR) 11 Other (specify)
 12 None used (open hole)
 SCREEN OR PERFORATION OPENINGS ARE:
 1 Continuous slot 3 Mill slot 5 Gauzed wrapped 8 Saw cut 11 None (open hole)
 2 Louvered shutter 4 Key punched 6 Wire wrapped 9 Drilled holes
 7 Torch cut 10 Other (specify) ft.
 SCREEN-PERFORATED INTERVALS: From 160 ft. to 180 ft., From 230 ft. to 240 ft.
 From ft. to ft., From ft. to ft.
 GRAVEL PACK INTERVALS: From 25 ft. to 250 ft., From ft. to ft.
 From ft. to ft., From ft. to ft.

6 GROUT MATERIAL: 1 Neat cement 2 Cement grout 3 Bentonite 4 Other
 Grout Intervals: From 0 ft. to 25 ft., From ft. to ft., From ft. to ft.
 What is the nearest source of possible contamination:
 1 Septic tank 4 Lateral lines 7 Pit privy 10 Livestock pens 14 Abandoned water well
 2 Sewer lines 5 Cess pool 8 Sewage lagoon 11 Fuel storage 15 Oil well/Gas well
 3 Watertight sewer lines 6 Seepage pit 9 Feedyard 12 Fertilizer storage 16 Other (specify below)
 13 Insecticide storage
 Direction from well? EAST How many feet? + 300'

FROM	TO	LITHOLOGIC LOG	FROM	TO	PLUGGING INTERVALS
0	3	Clay	183	189	Dark Limestone
3	7	Broken Lime	189	235	Grey Shale
7	26	Limestone	235	238	Very Sandy Shale
26	38	Shale	238	250	Limestone
38	52	Limestone			
52	86	Shale			
86	101	Limestone			
101	153	Shale			
153	161	Sandstone			
161	167	Shale			
167	168	Black Shale			
168	171	Shale			
171	180	Limestone			
180	183	Black Shale			

7 CONTRACTOR'S OR LANDOWNER'S CERTIFICATION: This water well was (1) constructed (2) reconstructed, or (3) plugged under my jurisdiction and was completed on (mo/day/year) 4/16/05 and this record is true to the best of my knowledge and belief. Kansas Water Well Contractor's Licence No. 595 This Water Well Record was completed on (mo/day/yr) 5/3/05 under the business name of Jesse Yoakum Well Drilling by (signature) Jesse Yoakum