

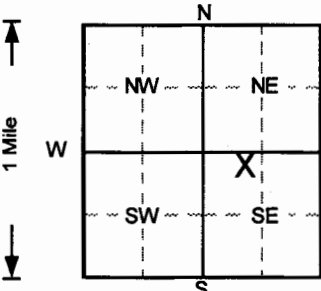
WATER WELL RECORD Form WWC-5 KSA 82a-1212

1 LOCATION OF WATER WELL: County: <b>Ness</b>	Fraction <b>NE 1/4 NW 1/4 SE 1/4</b>	Section Number <b>33</b>	Township Number <b>T 18 S</b>	Range Number <b>R 26 EW</b>
--	---	-----------------------------	----------------------------------	--------------------------------

Distance and direction from nearest town or city street address of well if located within city?

**Main Street, Beeler**

2 WATER WELL OWNER: <b>Dodge City Coop</b> RR#, St. Address, Box # : <b>710 W. Trail</b> City, State, ZIP Code : <b>Dodge City, Kansas 67801</b>	Board of Agriculture, Division of Water Resources Application Number:
--	--

3 LOCATE WELL'S LOCATION WITH AN "X" IN SECTION BOX: 	4 DEPTH OF COMPLETED WELL ..... <b>35</b> ..... ft. ELEVATION: ..... <b>2493.59</b> ..... Depth(s) Groundwater Encountered 1. .... ft. 2. .... ft. 3. .... ft. WELL'S STATIC WATER LEVEL ..... ft. below land surface measured on mo/day/yr ..... Pump test data: Well water was ..... <b>NA</b> ..... ft. after ..... hours pumping ..... gpm Est. Yield .. <b>NA</b> .. gpm: Well water was ..... ft. after ..... hours pumping ..... gpm Bore Hole Diameter ... <b>11</b> ... in. to ... <b>35</b> ... ft., and ... in. to ... ft. WELL WATER TO BE USED AS: 5 Public water supply 8 Air conditioning 11 Injection well 1 Domestic 3 Feedlot 6 Oil field water supply 9 Dewatering <b>12</b> Other (Specify below) 2 Irrigation 4 Industrial 7 Lawn and garden only 10 Monitoring well <b>Soil vapor extractio</b> Was a chemical/bacteriological sample submitted to Department? Yes.....No <input checked="" type="checkbox"/> ; If yes, mo/day/yr sample was submitted Water Well Disinfected? Yes No <input checked="" type="checkbox"/>
--	---

5 TYPE OF BLANK CASING USED: 1 Steel 3 RMP (SR) 5 Wrought iron 8 Concrete tile <b>2</b> PVC 4 ABS 7 Fiberglass Blank casing diameter ..... <b>4</b> ..... in. to ..... <b>25</b> ..... ft., Dia ..... in. to ..... ft., Dia ..... in. to ..... ft. Casing height above land surface ..... <b>-7.92</b> ..... in., weight ..... lbs./ft. Wall thickness or gauge No. .... <b>Sch. 40</b>	CASING JOINTS: Glued ..... Clamped ..... Welded ..... Threaded. <input checked="" type="checkbox"/>
TYPE OF SCREEN OR PERFORATION MATERIAL 1 Steel 3 Stainless steel 5 Fiberglass <b>7</b> PVC 10 Asbestos-cement 2 Brass 4 Galvanized steel 6 Concrete tile 8 RMP (SR) 11 Other (specify) ..... 12 None used (open hole)	SCREEN OR PERFORATION OPENINGS ARE: 1 Continuous slot <b>3</b> Mill slot 5 Gauzed wrapped 8 Saw cut 11 None (open hole) 2 Louvered shutter 4 Key punched 6 Wire wrapped 9 Drilled holes 7 Torch cut 10 Other (specify) .....
SCREEN-PERFORATED INTERVALS: From ..... <b>25</b> ..... ft. to ..... <b>35</b> ..... ft., From ..... ft. to ..... ft. From ..... ft. to ..... ft., From ..... ft. to ..... ft.	GRAVEL PACK INTERVALS: From ..... <b>5</b> ..... ft. to ..... <b>35</b> ..... ft., From ..... ft. to ..... ft. From ..... ft. to ..... ft., From ..... ft. to ..... ft.

6 GROUT MATERIAL: 1 Neat cement 2 Cement grout <b>3</b> Bentonite 4 Other .....	Grout Intervals: From ..... <b>2</b> ..... ft. to ..... <b>5</b> ..... ft., From ..... ft. to ..... ft., From ..... ft. to ..... ft.
What is the nearest source of possible contamination: 1 Septic tank 4 Lateral lines 7 Pit privy 10 Livestock pens 14 Abandoned water well 2 Sewer lines 5 Cess pool 8 Sewage lagoon 11 Fuel storage 15 Oil well/Gas well 3 Watertight sewer lines 6 Seepage pit 9 Feedyard 12 Fertilizer storage 16 Other (specify below) 13 Insecticide storage	Direction from well? How many feet?

FROM	TO	LITHOLOGIC LOG	FROM	TO	PLUGGING INTERVALS
0	1	Gravel road rock,			
1	2.5	Clay, v. silty, dry, no odor, Dark Brown			
2.5	7	Silt, w/caliche streaks, dry, Brown			
7	10	Silt, sl. clayey, dry, no odor, Brown			
10	12	Silt, w/caliche gravel, dry, Tan			
12	14	Silt, w/caliche gravel, sl. clayey, Brown			
14	21	Silt, w/caliche gravel, Tan			
21	30.5	Silt, sl. sandy, w/sl. weathered shale,			
30.5	31.5	Silt, sl. sandy, w/caliche gravel, Tan			
31.5	35	Clay, silty, moist, w/caliche streaks, Dark Gra			
					SVE2, Tag # 0042528, Flushmount
					Project Name: GF - Dodge City Coop - Beeler
					GeoCore # 1447, KDHE # A6 068 40273

7 CONTRACTOR'S OR LANDOWNER'S CERTIFICATION: This water well was <b>(1)</b> constructed, (2) reconstructed, or (3) plugged under my jurisdiction and was completed on (mo/day/year) ..... <b>7/17/2008</b> ..... and this record is true to the best of my knowledge and belief. Kansas Water Well Contractor's License No. .... <b>527</b> ..... This Water Well Record was completed on (mo/day/yr) <b>8/12/08</b> ..... under the business name of <b>GeoCore, Inc.</b> by (signature) <i>Dale Relf</i>
--