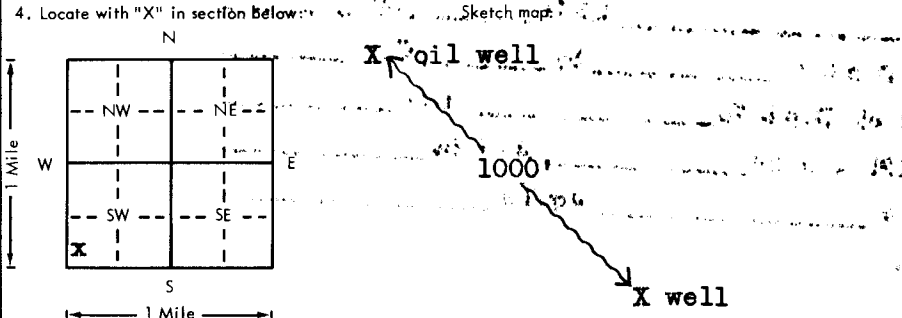


USE TYPEWRITER OR BALL POINT PEN-PRESS FIRMLY, PRINT CLEARLY.

BEELER

WATER WELL RECORD
KSA 82a-1201-1215

Kansas Department of Health and Environment-Division of Environment (Water well Contractors) Topeka, Kansas 66620

1. Location of well:		County Ness	Fraction S/W 1/4 S/W 1/4 S/W 1/4	Section number 24	Township number T 18 S	Range number R 26 #W
2. Distance and direction from nearest town or city: 2 E., 2 N., 1/2 E., 3/4 S. of Beeler, Kansas Street address of well location if in city:				3. Owner of well: George Sinn R.R. or street: 707 East Price City, state, zip code: Garden City, Kansas 67846		
4. Locate with "X" in section below: Sketch map: 				6. Bore hole dia. 9 in. Completion date 11/6/1978 Well depth 17 ft.		
5. Type and color of material				7. Cable tool <input checked="" type="checkbox"/> Rotary <input type="checkbox"/> Driven <input type="checkbox"/> Dug <input type="checkbox"/> Hollow rod <input type="checkbox"/> Jetted <input type="checkbox"/> Bored <input type="checkbox"/> Reverse rotary		
				8. Use: <input type="checkbox"/> Domestic <input type="checkbox"/> Public supply <input type="checkbox"/> Industry <input type="checkbox"/> Irrigation <input type="checkbox"/> Air conditioning <input checked="" type="checkbox"/> Stock <input type="checkbox"/> Lawn <input type="checkbox"/> Oil field water <input type="checkbox"/> Other		
From To				9. Casing: Material plastic Height: Above or below Threaded <input type="checkbox"/> Welded <input checked="" type="checkbox"/> Surface 12 in. RMP <input checked="" type="checkbox"/> PVC <input type="checkbox"/> Weight 1.8 lbs./ft. Dia. 5 in. to 10 ft. depth Wall Thickness: inches or Dia. <input type="checkbox"/> in. to <input type="checkbox"/> ft. depth Gage No. 250		
				10. Screen: Manufacturer's name Jess & Lowell Type RMP Dia. 5" Slot/gauze 1/16" Length 7' Set between 10 ft. and 17 ft. <input type="checkbox"/> ft. and <input type="checkbox"/> ft. Gravel pack? yes Size range of material 1/4 X 1/8"		
clay				0	7	11. Static water level: _____ mo./day/yr. 10 ft. below land surface Date 10/31/78
sand coarse				7	12	12. Pumping level below land surfaces: 15 ft. after 1 hrs. pumping 4 g.p.m. _____ ft. after _____ hrs. pumping _____ g.p.m. Estimated maximum yield _____ g.p.m.
clay				12	15	13. Water sample submitted: _____ mo./day/yr. Yes <input type="checkbox"/> No <input checked="" type="checkbox"/> Date _____
shale				15	17	14. Well head completion: <input type="checkbox"/> Pitless adapter _____ Inches above grade
BROCK 15' 10' S shale						15. Well grouted? yes With: <input checked="" type="checkbox"/> Neat cement <input type="checkbox"/> Bentonite <input type="checkbox"/> Concrete Depth: From 0 ft. to 10 ft.
						16. Nearest source of possible contamination: ft. 1000 Direction N/W Type oil well Well disinfected upon completion? <input checked="" type="checkbox"/> Yes <input type="checkbox"/> No
Alluvium						17. Pump: <input type="checkbox"/> Not installed Manufacturer's name Aermotor mill Model number _____ HP _____ Volts _____ Length of drop pipe 15 ft. capacity 4 g.p.m. Type: <input type="checkbox"/> Submersible <input type="checkbox"/> Turbine <input type="checkbox"/> Jet <input type="checkbox"/> Reciprocating <input type="checkbox"/> Centrifugal cylinder <input type="checkbox"/> Other
(Use a second sheet if needed)						
18. Elevation:		19. Remarks: 24/70 (top) 15 2465'				
Topography: <input type="checkbox"/> Hill <input type="checkbox"/> Slope <input checked="" type="checkbox"/> Upland <input type="checkbox"/> Valley		20. Water well contractor's certification: This well was drilled under my jurisdiction and this report is true to the best of my knowledge and belief. Weishaar Drilling & Sup. 232 Business name License No. _____ Address Scott City, KS 67871 Signature <i>[Signature]</i> Date 11/9/78 Authorized representative				

T 18
R 26
W 27
S W S W S W S W S W S W
Sec 1/4 1/4 1/4 1/4 1/4 1/4

Forward the white, blue and pink copies to the Department of Health and Environment

Form WWC-5