WATER WELL RECORD Form WWC-5 KSA 82a-1212

1 LOCATION OF WATER WELL:	Fraction	Section Number	Township Number	Range Number
County: NESS	NW ¼ NE ¼ NE ¼	35	T 18 S	R 26 EW

Distance and direction from nearest town or city street address of well if located within city?

1 1/2 mile EAST of BEELER, KS.

2 WATER WELL OWNER: BUD WATSON

RR#, St. Address, Box # : Board of Agriculture, Division of Water Resources

City, State, ZIP Code : BEELER, KS. 67518 Application Number:

3 LOCATE WELL'S LOCATION WITH AN "X" IN SECTION BOX:

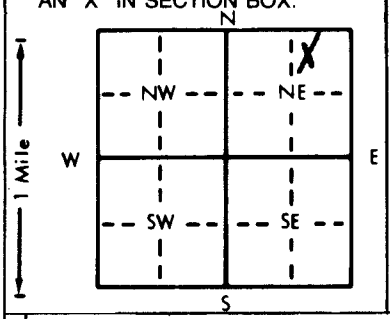

4 DEPTH OF COMPLETED WELL 45 ft. ELEVATION: VALLEY

Depth(s) Groundwater Encountered 1. 39 ft. 2. ft. 3. ft.

WELL'S STATIC WATER LEVEL 29 ft below land surface measured on mo/day/yr 6/1/81

Pump test data: Well water was 30 ft. after 2 hours pumping 15 gpm

Est. Yield 80 gpm: Well water was ft. after hours pumping gpm

Bore Hole Diameter 8 in. to 45 ft., and in. to ft.

WELL WATER TO BE USED AS: 1 Domestic 2 Irrigation 3 Feedlot 4 Industrial 5 Public water supply 6 Oil field water supply 7 Lawn and garden only 8 Air conditioning 9 Dewatering 10 Observation well 11 Injection well 12 Other (Specify below)

Was a chemical/bacteriological sample submitted to Department? Yes ..... No XX; If yes, mo/day/yr sample was submitted

Water Well Disinfected? Yes XX No

5 TYPE OF BLANK CASING USED: 1 Steel 2 PVC 3 RMP (SR) 4 ABS 5 Wrought iron 6 Asbestos-Cement 7 Fiberglass 8 Concrete tile 9 Other (specify below)

CASING JOINTS: Glued XX Clamped Welded Threaded

Blank casing diameter 5 in. to 25 ft., Dia in. to ft., Dia in. to ft.

Casing height above land surface 12 in., weight lbs./ft. Wall thickness or gauge No. 200 plus

TYPE OF SCREEN OR PERFORATION MATERIAL: 1 Steel 2 Brass 3 Stainless steel 4 Galvanized steel 5 Fiberglass 6 Concrete tile 7 PVC 8 RMP (SR) 9 ABS 10 Asbestos-cement 11 Other (specify) 12 None used (open hole)

SCREEN OR PERFORATION OPENINGS ARE: 1 Continuous slot 2 Louvered shutter 3 Mill slot 4 Key punched 5 Gauzed wrapped 6 Wire wrapped 7 Torch cut 8 Saw cut 9 Drilled holes 10 Other (specify) 11 None (open hole)

SCREEN-PERFORATED INTERVALS: From 25 ft. to 45 ft., From ft. to ft.

From ft. to ft., From ft. to ft.

GRAVEL PACK INTERVALS: From 15 ft. to 45 ft., From ft. to ft.

From ft. to ft., From ft. to ft.

6 GROUT MATERIAL: 1 Neat cement 2 Cement grout 3 Bentonite 4 Other

Grout Intervals: From 3 ft. to 15 ft., From ft. to ft., From ft. to ft.

What is the nearest source of possible contamination:

1 Septic tank 2 Sewer lines 3 Watertight sewer lines 4 Lateral lines 5 Cess pool 6 Seepage pit 7 Pit privy 8 Sewage lagoon 9 Feedyard 10 Livestock pens 11 Fuel storage 12 Fertilizer storage 13 Insecticide storage 14 Abandoned water well 15 Oil well/Gas well 16 Other (specify below)

Direction from well? North How many feet? 20

FROM	TO	LITHOLOGIC LOG	FROM	TO	LITHOLOGIC LOG
0	10	brown clay			
10	18	gray clay			
18	39	sand			
39	50	blue shale			

7 CONTRACTOR'S OR LANDOWNER'S CERTIFICATION: This water well was (1) constructed, (2) reconstructed, or (3) plugged under my jurisdiction and was completed on (mo/day/year) June 1, 1981 and this record is true to the best of my knowledge and belief. Kansas Water Well Contractor's License No. 243 This Water Well Record was completed on (mo/day/yr) June 15, 1981 under the business name of DEAN WATERHOUSE DRILLING by (signature) Dean Waterhouse

INSTRUCTIONS: Use typewriter or ball point pen, *PLEASE PRESS FIRMLY* and *PRINT* clearly. Please fill in blanks, underline or circle the correct answers. Send top three copies to Kansas Department of Health and Environment, Division of Environment, Environmental Geology Section, Topeka, KS 66620. Send one to WATER WELL OWNER and retain one for your records.

OFFICE USE ONLY T 18 R 26 EW SEC. 35 NW ¼ NE ¼ NE ¼