


1 LOCATION OF WATER WELL: County: Lane Fraction NW 1/4 NE 1/4 NW 1/4 Section Number 19 Township Number T 18 S Range Number R 28 E/W

Distance and direction from nearest town or city street address of well if located within city? JCM Trucking - 328 Long Steet - Dighton, KS

2 WATER WELL OWNER: Presta Oil Company RR#, St. Address, Box # : P.O. Box 1709 Board of Agriculture, Division of Water Resources City, State, ZIP Code : Garden City, Kansas 67846 Application Number:

3 LOCATE WELL'S LOCATION WITH AN "X" IN SECTION BOX:

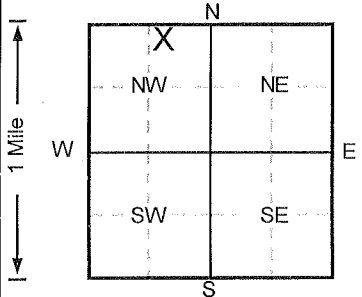

4 DEPTH OF COMPLETED WELL 65 ft. ELEVATION: 2763.86 Depth(s) Groundwater Encountered 1. 999 ft. 2. ft. 3. ft. WELL'S STATIC WATER LEVEL 999 ft. below land surface measured on mo/day/yr Pump test data: Well water was NA ft. after hours pumping gpm Est. Yield NA gpm: Well water was ft. after hours pumping gpm Bore Hole Diameter 8 in. to 65 ft. and in. to ft. WELL WATER TO BE USED AS: 5 Public water supply 8 Air conditioning 11 Injection well 1 Domestic 3 Feedlot 6 Oil field water supply 9 Dewatering 12 Other (Specify below) 2 Irrigation 4 Industrial 7 Lawn and garden only 10 Monitoring well Was a chemical/bacteriological sample submitted to Department? Yes.....No✓.....; If yes, mo/day/yr sample was submitted Water Well Disinfected? Yes No✓

5 TYPE OF BLANK CASING USED: 1 Steel 3 RMP (SR) 6 Asbestos-Cement 9 Other (specify below) CASING JOINTS: Glued Clamped 2 PVC 4 ABS 7 Fiberglass Welded Threaded. ✓ Blank casing diameter 2 in. to 45 ft., Dia in. to ft., Dia in. to ft. Casing height above land surface -2.88 in., weight lbs./ft. Wall thickness or gauge No. Sch. 40

TYPE OF SCREEN OR PERFORATION MATERIAL 1 Steel 3 Stainless steel 5 Fiberglass 7 PVC 10 Asbestos-cement 2 Brass 4 Galvanized steel 6 Concrete tile 9 ABS 11 Other (specify) 12 None used (open hole)

SCREEN OR PERFORATION OPENINGS ARE: 1 Continuous slot 3 Mill slot 5 Gauzed wrapped 8 Saw cut 11 None (open hole) 2 Louvered shutter 4 Key punched 6 Wire wrapped 9 Drilled holes 7 Torch cut 10 Other (specify)

SCREEN-PERFORATED INTERVALS: From 45 ft. to 65 ft. From ft. to ft. From ft. to ft. GRAVEL PACK INTERVALS: From 43 ft. to 65 ft. From ft. to ft. From ft. to ft.

6 GROUT MATERIAL: 1 Neat cement 2 Cement grout 3 Bentonite 4 Other Grout Intervals: From 0 ft. to 41 ft., From 41 ft. to 43 ft., From ft. to ft.

What is the nearest source of possible contamination: 1 Septic tank 4 Lateral lines 7 Pit privy 10 Livestock pens 14 Abandoned water well 2 Sewer lines 5 Cess pool 8 Sewage lagoon 11 Fuel storage 15 Oil well/Gas well 3 Watertight sewer lines 6 Seepage pit 9 Feedyard 12 Fertilizer storage 16 Other (specify below) Former UST Basin 13 Insecticide storage How many feet? 105 Direction from well? SW

Table with columns: FROM, TO, LITHOLOGIC LOG, FROM, TO, PLUGGING INTERVALS. Rows include: 0-0.5 Asphalt, 0.5-3 Clay, Dark Brown, 3-8 Clay, Light Brown, 8-32 Caliche, White to Tan, 32-49 Sand, Light Brown, 49-62 Sand, Red Brown, 62-65 Chalk, Buff to Tan. Includes MW2, Tag # 00174895, Flushmount, Project Name: J.C.M. Trucking, GeoCore # 357, KDHE # U1 051 909

7 CONTRACTOR'S OR LANDOWNER'S CERTIFICATION: This water well was (1) constructed, (2) reconstructed, or (3) plugged under my jurisdiction and was completed on (mo/day/year) 8/29/96 and this record is true to the best of my knowledge and belief. Kansas Water Well Contractor's License No. 527 This Water Well Record was completed on (mo/day/yr) 9/28/96 under the business name of GeoCore Services, Inc. by (signature) [Signature]

INSTRUCTIONS: Use typewriter or ball point pen. PLEASE PRESS FIRMLY and PRINT clearly. Please fill in blanks, underline or circle the correct answers. Send top three copies to Kansas Department of Health and Environment, Bureau of Water, Topeka, Kansas 66620-0001. Telephone: 913-296-5545. Send one to WATER WELL OWNER and retain one for your records.