SHIELDS

USE TYPEWRITER OR BALL POINT PEN-PRESS FIRMLY, PRINT CLEARLY.

WATER WELL RECORD
KSA 82a-1201-1215

ACA

Kansas Department of Health and Environment-Division of Environment
(Water well Contractors)
Topeka, Kansas 66620

1. Location of well:	County	Fraction	Section number	Township number	Range number
	Lane	NE 1/4 SW 1/4 NE 1/4	5	T 18 S	R 28 E (W)

2. Distance and direction from nearest town or city: 2N, 1E of
Street address of well location if in city: Dighton, KS

3. Owner of well: O. C. Johnston
R.R. or street:
City, state, zip code: Dighton, KS 67839

4. Locate with "X" in section below:

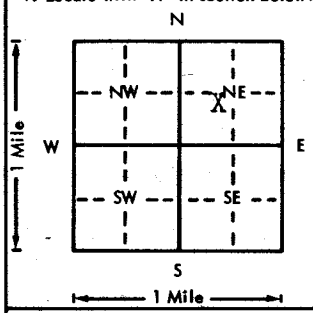

Sketch map:

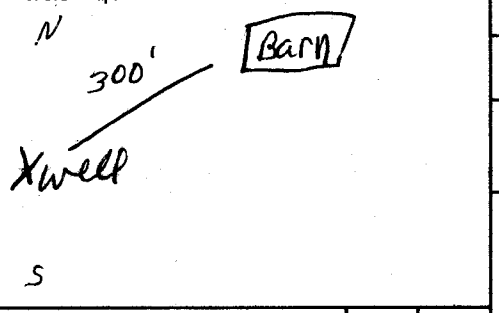

6. Bore hole dia. 9 in. Completion date
Well depth 45 ft. 8-29-75

7. __ Cable tool X Rotary __ Driven __ Dug
__ Hollow rod __ Jetted __ Bored __ Reverse rotary

8. Use: __ Domestic X Public supply __ Industry
__ Irrigation __ Air conditioning __ Stock
__ Lawn __ Oil field water __ Other

9. Casing: Material Plas. Height: Above or below
Threaded ___ Welded glue Surface 12 in.
RMP X PVC ___ Weight 1.8 lbs./ft.
Dia. 5 in. to 25 ft. depth Wall Thickness: inches or
Dia. ___ in. to ___ ft. depth gage No. .250

10. Screen: Manufacturer's name Jess & Lowell
Type RMP Dia. 5 in.
Slot/gauze 1/16 Length 20 ft.
Set between 25 ft. and 45 ft.
ft. and ft.
Gravel pack? yes Size range of material 1/2-1/8

11. Static water level: mo./day/yr.
35 ft. below land surface Date 8-29-75

12. Pumping level below land surfaces: NA
ft. after hrs. pumping g.p.m.
ft. after hrs. pumping g.p.m.
Estimated maximum yield g.p.m.

13. Water sample submitted: mo./day/yr.
__ Yes X No Date

14. Well head completion: NA
__ Pitless adapter ___ Inches above grade

15. Well grouted? yes
With: X Neat cement __ Bentonite __ Concrete
Depth: From 0 ft. to 15 ft.

16. Nearest source of possible contamination: feed
ft. Direction Middle of Type lot
Well disinfected upon completion? XX Yes __ No

17. Pump: X Not installed
Manufacturer's name
Model number HP Volts
Length of drop pipe ft. capacity g.p.m.
Type:
__ Submersible __ Turbine
__ Jet __ Reciprocating
__ Centrifugal __ Other

5. Type and color of material	From	To
Clay	0	23
Sd coarse	23	29
Clay	29	31
Sd rock	31	34
Sd	34	42
Clay yellow	42	45
BROCK 42'		

(Use a second sheet if needed)

18. Elevation:
Topography:
__ Hill
__ Slope
__ Upland
X Valley

19. Remarks:
Do not know well head completion, since well was not finished by us.
2758 (TOPO)

20. Water well contractor's certification:
This well was drilled under my jurisdiction and this report is true to the best of my knowledge and belief.
Weishaar Drilling 232
Business name License No.
Address Scott City, KS 67871
Signature Authorized representative Date 10-29-75

T 18 R 28 (W) Sec 5 NE SW NE 1/4 1/4 1/4

Forward the white, blue and pink copies to the Department of Health and Environment

Form WWC-5

MI-1023