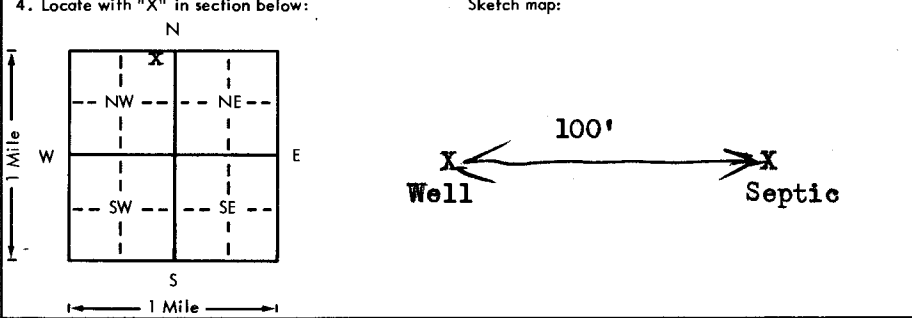


USE TYPEWRITER OR BALL POINT PEN-PRESS FIRMLY, PRINT CLEARLY.

WATER WELL RECORD  
KSA 82a-1201-1215

Kansas Department of Health and Environment-Division of Environment  
(Water well Contractors)  
Topeka, Kansas 66620

1. Location of well:	County <b>Lane</b>	Fraction <b>NE 1/4 NE 1/4 NW 1/4</b>	Section number <b>21</b>	Township number <b>T 18 S R 28</b>	Range number <b>W</b>
2. Distance and direction from nearest town or city: <b>2 1/4 Miles East of Dighton, Kansas</b> Street address of well location if in city:			3. Owner of well: <b>Delmar Dunham</b> R.R. or street: City, state, zip code: <b>Dighton, Kansas 67839</b>		
4. Locate with "X" in section below: 			6. Bore hole dia. <u>9</u> in. Completion date _____ Well depth <u>75</u> ft. <u>6/14/79</u>		
5. Type and color of material			7. <input checked="" type="checkbox"/> Cable tool <input checked="" type="checkbox"/> Rotary <input type="checkbox"/> Driven <input type="checkbox"/> Dug <input type="checkbox"/> Hollow rod <input type="checkbox"/> Jetted <input type="checkbox"/> Bored <input type="checkbox"/> Reverse rotary		
			8. Use: <input checked="" type="checkbox"/> Domestic <input type="checkbox"/> Public supply <input type="checkbox"/> Industry <input type="checkbox"/> Irrigation <input type="checkbox"/> Air conditioning <input type="checkbox"/> Stock <input type="checkbox"/> Lawn <input type="checkbox"/> Oil field water <input type="checkbox"/> Other		
			9. Casing: Material <u>Plastic</u> Weight: Above or below Threading <u>Glue</u> Surface <u>12</u> in. RMP <input checked="" type="checkbox"/> PVC <input type="checkbox"/> Weight <u>1.8</u> lbs./ft. Dia. <u>0</u> in. to <u>49</u> ft. depth Wall Thickness: inches or Dia. _____ in. to _____ ft. depth gage No. <u>.250</u>		
			10. Screen: Manufacturer's name <u>Jess &amp; Lowell</u> Type <u>RMP</u> Dia. <u>5"</u> Slot/gauze <u>1/16"</u> Length <u>26'</u> Set between <u>49</u> ft. and <u>75</u> ft. Gravel pack? <input checked="" type="checkbox"/> Size range of material <u>1/8"</u>		
			11. Static water level: _____ mo./day/yr. <u>41</u> ft. below land surface Date <u>6/14/79</u>		
			12. Pumping level below land surfaces: <u>NA</u> _____ ft. after _____ hrs. pumping _____ g.p.m. _____ ft. after _____ hrs. pumping _____ g.p.m. Estimated maximum yield _____ g.p.m.		
			13. Water sample submitted: _____ mo./day/yr. <input type="checkbox"/> Yes <input checked="" type="checkbox"/> No Date _____		
			14. Well head completion: <input type="checkbox"/> Pitless adapter <u>12</u> Inches above grade		
			15. Well grouted? <input checked="" type="checkbox"/> <u>yes</u> With: <input checked="" type="checkbox"/> Neat cement <input type="checkbox"/> Bentonite <input type="checkbox"/> Concrete Depth: From <u>0</u> ft. to <u>15</u> ft.		
			16. Nearest source of possible contamination: ft. <u>100</u> Direction <u>East</u> Type <u>Septic</u> Well disinfected upon completion? <input checked="" type="checkbox"/> Yes <input type="checkbox"/> No		
			17. Pump: <input checked="" type="checkbox"/> Not installed Manufacturer's name _____ Model number _____ HP _____ Volts _____ Length of drop pipe _____ ft. capacity _____ g.p.m. Type: <input type="checkbox"/> Submersible <input type="checkbox"/> Turbine <input type="checkbox"/> Jet <input type="checkbox"/> Reciprocating <input type="checkbox"/> Centrifugal <input type="checkbox"/> Other		
			20. Water well contractor's certification: This well was drilled under my jurisdiction and this report is true to the best of my knowledge and belief. <b>Weishaar Drilling</b> 232 Business name License No. _____ Address <u>Scott City, Kansas 67871</u> Signed <u>[Signature]</u> Date <u>6/14/79</u> Authorized representative		
18. Elevation:	19. Remarks:				
Topography: <input type="checkbox"/> Hill <input checked="" type="checkbox"/> Slope <input type="checkbox"/> Upland <input type="checkbox"/> Valley					

T 18 S R 28 W  
Sec 21

Forward the white, blue and pink copies to the Department of Health and Environment

Form WWC-5