


WATER WELL RECORD Form WWC-5 KSA 82a-1212

1 LOCATION OF WATER WELL: Fraction Section Number Township Number Range Number
 COUNTY: 051 LANE NE 1/4 SW 1/4 SE 1/4 23 T 18 S R 28 W

Distance and direction from nearest town or city street address of well if located within city?
 FROM DIGHTON; APPX 4 MILES EAST

2 WATER WELL OWNER: RANGER FEEDERS II, LLC Board of Agriculture, Division of Water Resources
 RR#, St. Address, Box #: PO BOX 880 Application Number: 45933
 City, State, ZIP code: DIGHTON, KS 67839-0880

3 LOCATE WELL'S LOCATION WITH AN "X" IN SECTION BOX:

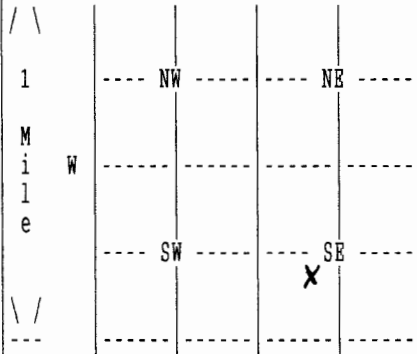

4 DEPTH OF COMPLETED WELL ELEVATION: 0
 Depth(s) Groundwater Encountered 1. 0 ft. 2. 0 ft. 3. 0 ft.

WELL'S STATIC WATER LEVEL 14 ft. below land surface measured on mo/day/yr 08/25/04
 Pump test data: Well water was 30 ft. after 1 hours pumping 33 gpm

Estimated Yield 0 gpm: Well water was 0 ft. after 0 hours pumping 0 gpm

Bore Hole Diameter 11 in. to 61 ft., and in. to 0 ft.

WELL WATER TO BE USED AS: 03 FEEDLOT

Was a chemical/bacteriological sample submitted to department? No;
 If yes, mo/day/yr sample was submitted Water well disinfected? Yes

5 TYPE OF BLANK CASING USED: 02 PVC CASING JOINTS: GLUED
 Blank casing diameter 6 in. to 61 ft., Dia in. to 0 ft., Dia in. to 0 ft.
 Casing height above land surface 12 in., weight 4 lbs/ft. Wall thickness or gauge No. .316
 TYPE OF SCREEN OR PERFORATION MATERIAL: 01 STEEL
 SCREEN OR PERFORATION OPENINGS ARE: 03 MILL SLOT

SCREEN PERFORATED INTERVALS: From 20 ft. to 40 ft., From 0 ft. to 0 ft.
 From 0 ft. to 0 ft., From 0 ft. to 0 ft.
 GRAVEL PACK INTERVALS: From 20 ft. to 61 ft., From 0 ft. to 0 ft.
 From 0 ft. to 0 ft., From 0 ft. to 0 ft.

6 GROUT MATERIAL 03 BENTONITE
 Grout Intervals: From 0 ft. to 20 ft., From 0 ft. to 0 ft., From 0 ft. to 0 ft.
 What is the nearest source of possible contamination: NONE OBSERVED
 Direction from well? How many feet? 0

FROM	TO	LITHOLOGIC LOG	FROM	TO	PLUGGING INTERVALS
0	2	02 SILT			
2	17	04 SANDY CLAY			
17	19	07 FINE SAND 08 MEDIUM SAND 28 ROCK			
19	21	01 CLAY			
21	36	07 FINE SAND 08 MEDIUM SAND 28 ROCK			
36	62	19 SHALE			

7 CONTRACTOR'S OR LANDOWNER'S CERTIFICATION: This water well was Constructed under my jurisdiction and was completed on (mo/day/year) 07/16/04 and this record is true to the best of my knowledge and belief. Kansas Water Well Contractor's License No. 145 This Water Well Record was completed on (mo/day/yr) 08/31/04 under the business name of HENKLE DRILLING & SUPPLY by (signature) .